

KANSAS

Stafford

Section 16 Township 24 Range 15WWell No. 1 O'ConnerCompany Huber Oil


O. W. D. D

Wildcat

NORTH

WEST

EAST

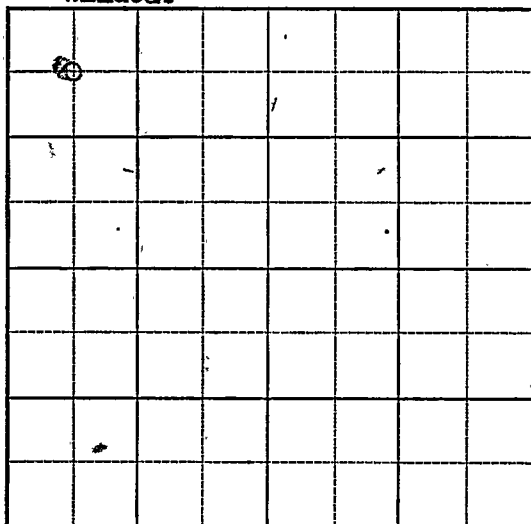


SOUTH

KANSAS
Stafford ✓Sec. 16 Twp. 24 R. 15WWell No. #1 O'Conner FarmHuber Oil Company

Wildcat

660 Ft. from N. Line Ft. from S. Line Ft. from E. Line660 Ft. from W. Line

C NW NW

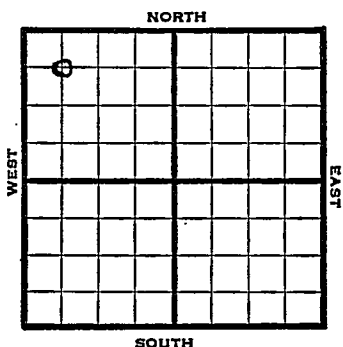

1947

Elev. 2036

REPORT

4/2

RUR

4/9

8" @ 280'
Drlg. 2200'.

4/15

Lansing 3654'
Viola 3996'
Drlg. 4020'

4/23

Simp 4027'
Arb 4061
5" @ 4063
TD 4068'
Tst 5 $\frac{1}{2}$ M gas

4/30

Arb 4061
5" @ 4063
2000 Acid
26 M Gas
1200# R Pr
TD 4073'COMPLETED

O. W. D. D

1950

5/24

Lans 3654
Arb 4061
TD 4073
5" @ 4063

OVER

1950

5/24 Information brought forward

P B 4068 S/1BWDH

P B 4060

9/4051-54 N/S

P B 3800

21/3778-85 8 gal. per hour

100A S/24B & 12 BWPD 3000A S/96 BO &
35 WPD

P 101 BO 35 PW 26H

Completed

Map No. K83 Sec. 16 Twp. 24 R. 15W

Well No. 1 O'Conner

Huber Oil Company

FIRST REPORT Contractor

C NW NW

SECTION PLAT

660 Ft. from N. Line

 Ft. from S. Line

 Ft. from E. Line

660 Ft. from W. Line

o			

Stafford County

Location

Rig up

Drilling and Remarks:

R U R

RECORD

Cased in., ft.

Sand

Gas

Oil

Total Depth

PRODUCTION

1st 24 hrs. Nat.

1st 24 hrs. after shot

Gas Cu. Ft.

Dry Hole

Abandoned

Date

APR 2 1947 19

S. J. LEWIS Scout

Map No. 83 Sec. 16 Twp. 24 R. 15WWell No. 1 O'Conner

Huber Oil

Company

COMPLETE

Contractor

C NW NW

E12086

SECTION PLAT

660 Ft. from N. Line Ft. from S. Line Ft. from E. Line660 Ft. from W. Line

0			

Stafford CountyLocation Rig up

Drilling and Remarks:

Per 4061
5' 04063
2000 Rev
26 M Gas

1200 # R/2

RECORD

Cased in., ft.Sand Gas Oil Total Depth 4023

PRODUCTION

1st 24 hrs. Nat. 1st 24 hrs. after shot Gas Cu. Ft.Dry Hole Abandoned

Date

APR 30 1947 19

S. J. LEWIS

Scout

Map No. _____ Sec. 16 Twp. 24 R. 15WWell No. 1 O'Conner

Huber Corp. _____ Company

_____ Contractor

C NW NW

E1.2036

SECTION PLAT

660 Ft. from N. Line

_____ Ft. from S. Line

_____ Ft. from E. Line

660 Ft. from W. Line

o			
FIRST	REF	CON	
COMPLETE			

Stafford O'DD

Location _____

Rig up _____

Drilling and Remarks:

Lans. 3654

Arb. 4061

OTD 4073

5" C 4' 63

P. B. 4068 S/1BWDH

P. B. 4060

9/4051-54 N/S

P. B. 3800

RECORD

Cased _____ in., _____ ft.

Sand _____

Gas _____

Oil _____

Total Depth _____

PRODUCTION

1st 24 hrs. Nat. _____

1st 24 hrs. after shot _____

Gas _____ Cu. Ft.

Dry Hole _____

Abandoned _____

21/3778-85 8 gal. per Hour

Date


MAY 24 1950 19

J. E. TYRA Scout

over

100A S/24B & 12 BWPD 3000A S/96B0 & 35 WPD
P 101 B0 35PW 26H

Complete

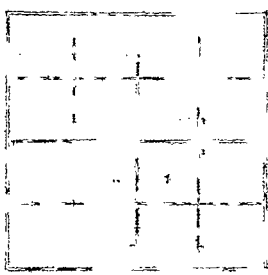

MAY 26 1950

Scout Cards	
Land Small Map	
Land Wall Map	
Tracings	
France Map	
Pierce Map	
Misc.	