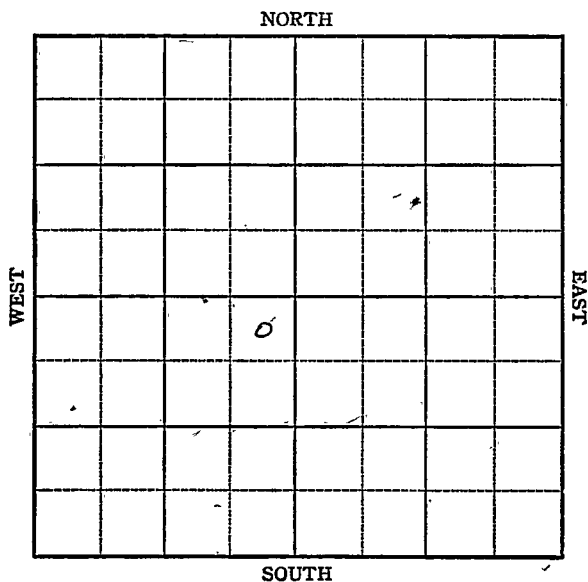


KANSAS

Finney county

Section 16 Township 24 Range 34-WWell No. #1, BiehnCompany Champlin Refg.

KANSAS

Finney County


Sec. 16 Twp. 24 R. 34-W

Well No. 1 Biehn Farm

Champlin Ref. Company

Hugoton Pool

NORTH

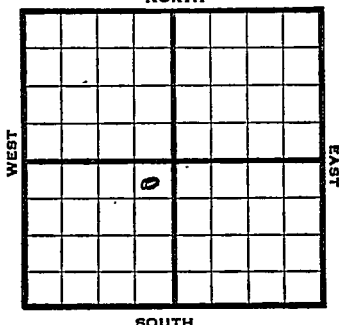

330 Ft. from N. Line

Ft. from S. Line

330 Ft. from E. Line

Ft. from W. Line

NE SW

SOUTH

1947

REPORT

1/15 10" @ 599'
drlg. 2430'

1/21 TD 2600
7" @ 2600
RUST

1/30 " "

2/5 " "

2/12 " "

2/19 " "

2/26 " "

3/4 TD 2600'

3/11 " "

3/18 144 shots 2555-90 - 1500 acid
100 shots 2500-25 - 1500 acid
160 shots 2440-80 - 10,000 acid

3/25 " " "

4/2 " " "

4/9 " " "

4/15 " " "

4/23 144 shots 2555-90 1500 acid
100 shots 2500-25 1500 acid
160 shots 2440-80 10,000 acid
25000 acid

4/29 " " "

5/7 25000 Acid

5/13 " "

5/20 " "

5/27 " "

6/3 " "

6/10 " "

6/17 " "

6/24 " "

7/1 " "

7/8 " "

7/16 " "

7/22 " "

7/29 " "

8/6 " "

8/13 " "

8/20 " "

8/27 " "

9/3 " "

9/10 " "

9/17 " "

9/24 " "

10/1 " "

10/8 " "

10/15 " "

1947

10/22 25000 acid

10/29 7" @ 2600'
Perf. 50,000 Acid
5 M Gas
TD 2600'
420# RPr

COMPLETED

Map No. _____ Sec. 16 Twp. 24 R. 34WWell No. 1 Biehn

Champlin Ref. _____ Company _____

FIRST REPORT Contractor _____

NE SW

SECTION PLAT

330 Ft. from N. Line

_____ Ft. from S. Line

330 Ft. from E. Line

_____ Ft. from W. Line

	o		

Finney County

Location _____

Rig up _____

Drilling and Remarks:

10" @ 599

drlg. 2430

RECORD

Cased _____ in, _____ ft.

Sand _____

Gas _____

Oil _____

Total Depth _____

PRODUCTION

1st 24 hrs. Nat. _____

1st 24 hrs. after shot _____

Gas _____ Cu. Ft.

Dry Hole _____

Abandoned _____

Date

JAN 15 1947 19. _____ S. J. LEWIS Scout

Map No. 0 Sec. 16 Twp. 24 R. 34W

Well No. 1 Biehn

Champlin Ref. Company

COMPLETE

Contractor

NE SW

E12918
SECTION PLAT

330 Ft. from N. Line

 Ft. from S. Line

330 Ft. from E. Line

 Ft. from W. Line

	0		

Finney County

Location

Rig up

Drilling and Remarks:

7" @ 2600

Ref.

5000000000

5M Gas

420 # R/A

RECORD

Cased in. ft.

Sand

Gas

Oil

Total Depth 2600

PRODUCTION

1st 24 hrs. Nat.

1st 24 hrs. after shot

Gas Cu. Ft.

Dry Hole

Abandoned

Date

OCT 29 1947

S. J. LEWIS

Scout