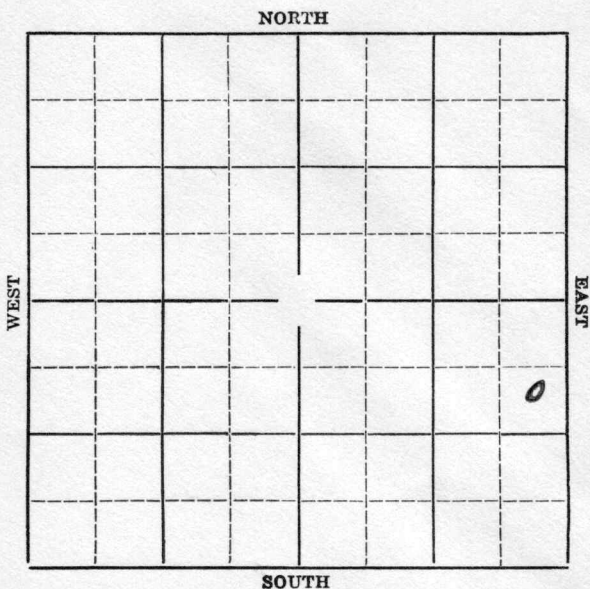


Section 17 Township 24 Range 4-WWell Number 5-Sam CollinsCompany Texas

Well No. 5-Sam Collins Farm

Texas	Company
-------	---------

990 Ft. from N. Line


Ft. from S. Line

330 Ft. from E. Line

Ft. from W. Line

Elev. 1476

NORTH

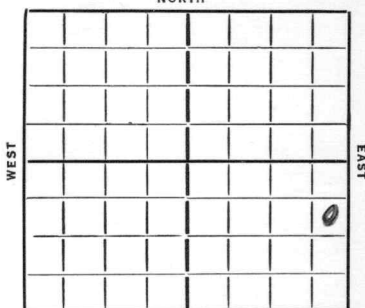

SOUTH

Date
1936

REPORT

4/15 Rig

4/23 Drlg. 606'

4/30 Drlg. 3020'.

5/7 Chat 3303'-8" 3340'. T.D. 3382'.

5/13/36- Chat 3303'.

T.D. 3382'.

507 bbls.

COMPLETED

Map No. 40 Sec. 17 Twp. 24 R. 4 N

Well No. 5 Sam Collins

Texas Company

Contractor

SECTION PLAT

990 Ft. from N. Line

..... Ft. from S. Line

930 Ft. from E. Line

..... Ft. from W. Line

			0

FIRST REPORT

Location.....

Rig up.....

Drilling and Remarks:

Rig

RECORD

Cased.....in.,ft.

Sand.....

Gas.....

Oil.....

Total Depth.....

PRODUCTION

1st 24 hrs. Nat.....

1st 24 hrs. after shot.....

Gas.....Cu. Ft.

Dry Hole.....

Abandoned.....

Date

APR 15 1936

192

S. J. LEWIS

Scout

KANSAS

Map No. 40 Sec. 17 Twp. 24 R. 4WWell No. 5 Sam CollinsTexas Company

Contractor

SECTION PLAT

			0

990 Ft. from N. Line

_____ Ft. from S. Line

330 Ft. from E. Line

_____ Ft. from W. Line

COMPLETED

Location _____

Rig up _____

Drilling and Remarks:

Cha 83303507 8 1/2

RECORD

Cased _____ in., _____ ft.

Sand _____

Gas _____

Oil _____

Total Depth 3382

PRODUCTION

1st 24 hrs. Nat. _____

1st 24 hrs. after shot _____

Gas _____ Cu. Ft.

Dry Hole _____

Abandoned _____

Date

MAY 13 1936

19

S. J. LEWIS

Scout