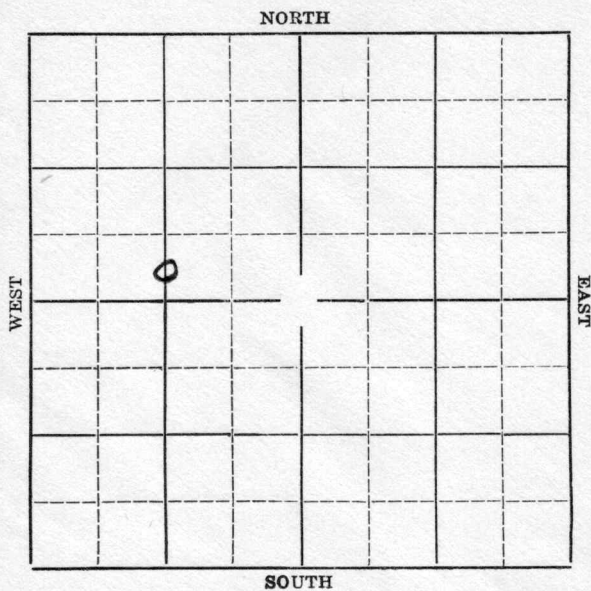


Section 17 Township 24 Range 4-WWell Number #2 Burton State BankCompany Tidewater Oil

Reno

Map No. KANSAS Sec. 17 Twp. 24 R. 4W

Well No. #2 Burton State Bank Farm
Tidewater Oil Company


 Ft. from N. Line

330' Ft. from S. Line

 Ft. from E. Line

1320' Ft. from W. Line

Elev. 1472

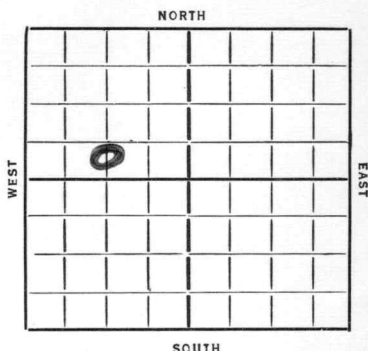

Date 1936

REPORT

7/22 Rigging up.
7/30 12" @ 511'. Waiting on cement.
8/6 Drlg. 1836'.
8/13 Drlg. 2477'.
8/20 Drlg. 3295'.
8/27 Chat 3312'. 7" @ 3321'. Drlg. 3323'.
9/3 TD 3362'. Swab 75 bbls of oil and
water.
9/9/36 Chat 3312'.
T.D. 3362'.
Potential 346 bbls of oil.


COMPLETED

KANSAS

Map No. 40 Sec. 17 Twp. 24 R. 4WWell No. 2. Burton State Bank.Stolwaters Oil Company

Contractor

SECTION PLAT

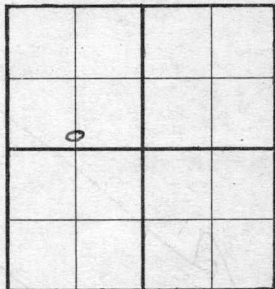 Ft. from N. Line330 Ft. from S. Line Ft. from E. Line1820 Ft. from W. Line

FIRST REPORT

Location Rig up

Drilling and Remarks:

Rigging up

RECORD

Cased in., ft.Sand Gas Oil Total Depth

PRODUCTION

1st 24 hrs. Nat. 1st 24 hrs. after shot Gas Cu. Ft.Dry Hole Abandoned

Date

JUL 22 1936 19

S. J. LEWIS

Scout

KANSAS

Map No. 40 Sec. 17 Twp. 24 R. 4WWell No. 2 State BankTide water Oil Company

Contractor

SECTION PLAT

_____ Ft. from N. Line

830 Ft. from S. Line

_____ Ft. from E. Line

1320 Ft. from W. Line

COMPLETED

Location _____

Rig up _____

Drilling and Remarks:

Oha 43312Po 4346.

RECORD

Cased _____ in., _____ ft.

Sand _____

Gas _____

Oil _____

Total Depth 3362

PRODUCTION

1st 24 hrs. Nat. _____

1st 24 hrs. after shot _____

Gas _____ Cu. Ft.

Dry Hole _____

Abandoned _____

Date

SEP 9 1936

S. J. LEWIS Scout