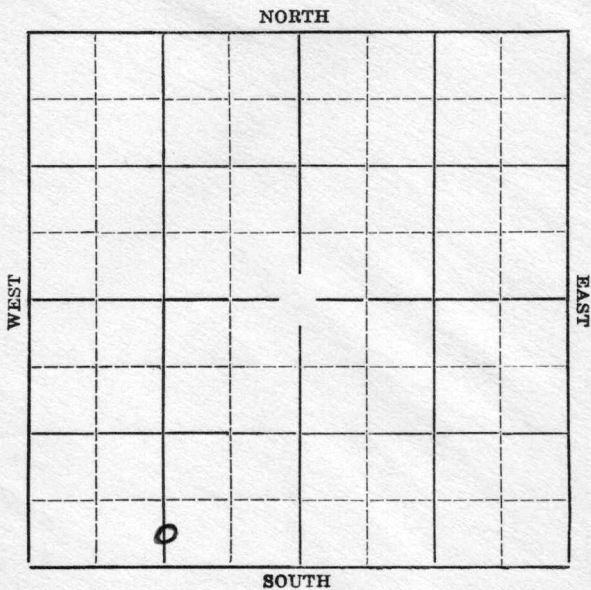


Section 17 Township 24 Range 4-WWell Number #5-ScheutzerCompany McPherson Dlg.

Map No. KANSAS Sec. 17 Twp. 24 R. 4W


Well No. #5 Schentzer Farm
McPherson Drlg. Company

 Ft. from N. Line

330' Ft. from S. Line

 Ft. from E. Line

1320' Ft. from W. Line

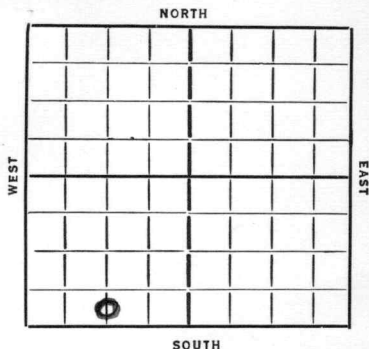

Date
1936


REPORT

5/27 Location

6/4 Cellar.

6/10/36-Cellar. D & A.

ABANDONED

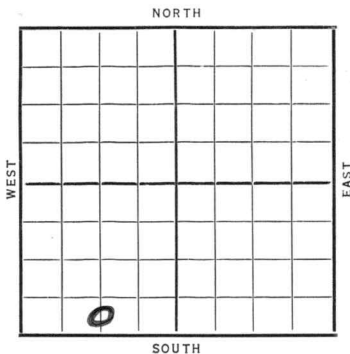

COMPLETED

Map No. 40 Sec. 17 Twp. 24 R. 4WWell No. 5 SchuetzJ. C. Pherson, Inc. Company

Contractor

SECTION PLAT

_____ Ft. from N. Line

330 Ft. from S. Line

_____ Ft. from E. Line

1320 Ft. from W. Line

FIRST REPORT

Location _____

Rig up _____

Drilling and Remarks:

Rigging up.

RECORD

Cased _____ in., _____ ft.

Sand _____

Gas _____

Oil _____

Total Depth _____

PRODUCTION

1st 24 hrs. Nat. _____

1st 24 hrs. after shot _____

Gas _____ Cu. Ft.

Dry Hole _____

Abandoned _____

Date

SEP 2 1936


19

S. J. LEWIS

Scout

Map No. 40 Sec. 17 Twp. 24 R. 4WWell No. 5 SchenitzerW. C. Pherson Drilling Company
Contractor

SECTION PLAT

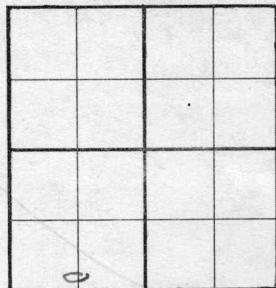 Ft. from N. Line330 Ft. from S. Line Ft. from E. Line1820 Ft. from W. Line

COMPLETED

Location Rig up

Drilling and Remarks:

Qha 833161000 acidFlow 940 x 1/2

RECORD

Cased in., ft.Sand Gas Oil Total Depth 3329

PRODUCTION

1st 24 hrs. Nat. 1st 24 hrs. after shot Gas Cu. Ft.Dry Hole Abandoned

Date

NOV 4 1936 19

S. J. LEWIS Scout

Map No. 410 Sec. 17 Twp. 24 R. 4WWell No. 5 SchenkerMcPherson Company

Contractor

SECTION PLAT

_____ Ft. from N. Line

330 Ft. from S. Line

_____ Ft. from E. Line

1320 Ft. from W. Line

FIRST REPORT

Location ✓

RECORD

Cased _____ in., _____ ft.

Sand _____

Gas _____

Oil _____

Total Depth _____

PRODUCTION

1st 24 hrs. Nat. _____

1st 24 hrs. after shot _____

Gas _____ Cu. Ft.

Dry Hole _____

Abandoned _____

Date

MAY 27 1936

19

S. J. LEWIS

Scout

Map No. KANSAS Sec. 17 Twp. 24 R. 4W

Well No. 5 Schue tge

M. P. Sherron Dr. Co. Company

Contractor

SECTION PLAT

_____ Ft. from N. Line

330 Ft. from S. Line

_____ Ft. from E. Line

1320 Ft. from W. Line

ABANDONED

Location _____

Rig up _____

Drilling and Remarks:

Ce Hall

D & A

RECORD

Cased _____ in., _____ ft.

Sand _____

Gas _____

Oil _____

Total Depth _____

PRODUCTION

1st 24 hrs. Nat. _____

1st 24 hrs. after shot _____

Gas _____ Cu. Ft.

Dry Hole _____

Abandoned _____

Date

JUN 10 1936

19

Scout