
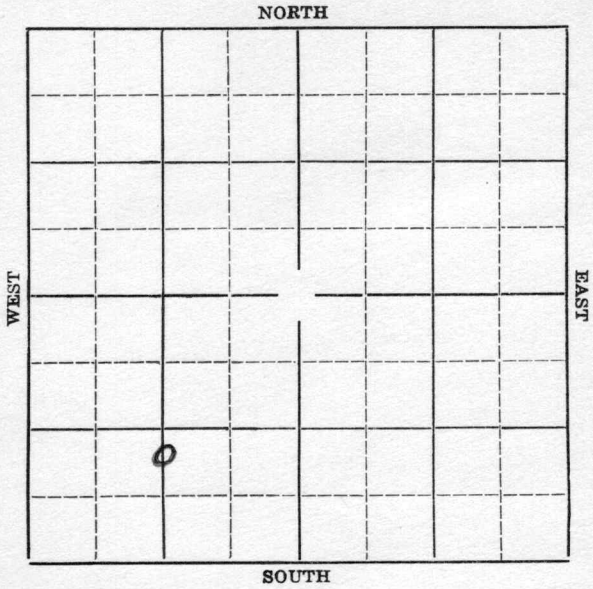


Section 17 Township 24 Range 4-WWell Number 2-ScheuchzerCompany McPherson Dig.

Map No. KANSAS Sec. 17 Twp. 24 R. 4-W

Well No. 2-Scheuchzer Farm
McPherson Dlg. Company

 Ft. from N. Line
990 Ft. from S. Line
 Ft. from E. Line
1320 Ft. from W. Line

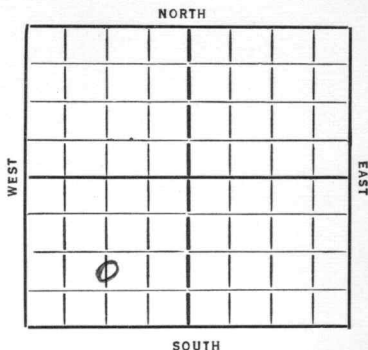

Elev. 1470

Date
1936

REPORT

5/6 Rig
5/14 Rigging up.
5/21 Drlg. 1380'.
5/28 Drlg. 2131'.
6/4 Drlg. 3007'.
6/11 Chat 3307'. T.D. 3313'.

6/17/36-Chat 3307' ~~kk~~
T.D. 3381'.
2000 gallons acid.
1515 bbls oil potential.

COMPLETED

KANSAS

Map No. 50 Sec. 17 Twp. 24 R. 4WWell No. 2 SchuchterMcPherson Drilling Company

Contractor

SECTION PLAT

_____ Ft. from N. Line

990 Ft. from S. Line

_____ Ft. from E. Line

1320 Ft. from W. Line

Location _____

Rig up _____

Drilling and Remarks:

Rig

RECORD

Cased _____ in., _____ ft.

Sand _____

Gas _____

Oil _____

Total Depth _____

PRODUCTION

1st 24 hrs. Nat. _____

1st 24 hrs. after shot _____

Gas _____ Cu. Ft.

Dry Hole _____

Abandoned _____

Date

5/6/36

19

S. J. LEWIS

Scout

Map No. 40 Sec. 17 Twp. 24 R. 4WWell No. 2 SchentzesMcPherson Drilling Company

Contractor

SECTION PLAT

_____ Ft. from N. Line

990 Ft. from S. Line

_____ Ft. from E. Line

1320 Ft. from W. Line

COMPLETED

Location _____

Rig up _____

Drilling and Remarks:

@ hat 33072000 acidPx 1515

RECORD

Cased _____ in., _____ ft.

Sand _____

Gas _____

Oil _____

Total Depth 3381

PRODUCTION

1st 24 hrs. Nat. _____

1st 24 hrs. after shot _____

Gas _____ Cu. Ft.

Dry Hole _____

Abandoned _____

Date

JUN 17 1936

19

S. J. LEWIS

Scout