


Form 51-5M-3-35-Mid-West

Map No. **KANSAS** Sec. **17** Twp. **24** R. **4-W**

Well No. 2-Seedle Farm
Sinclair-Prairie Company

NORTH

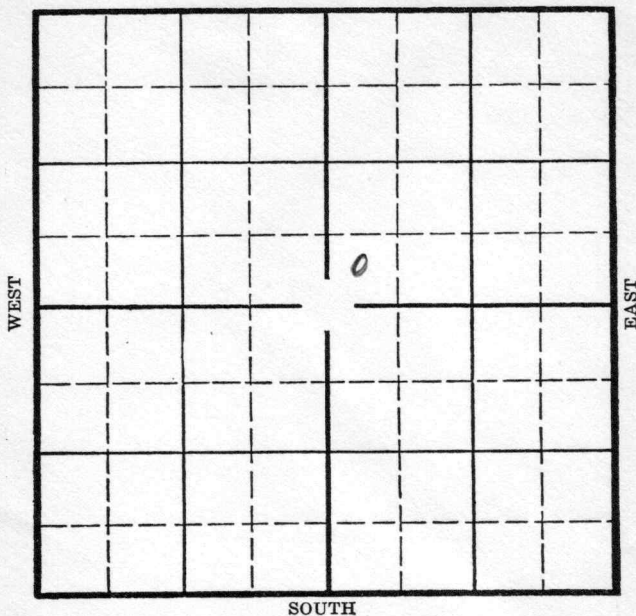

Location _____
Drilling Remarks _____

Rig Up.....
Drilling Remarks

RECORD

Cased _____ in. _____ ft.
 Sand _____
 Gas _____
 Oil _____
 Total Depth _____

PRODUCTION

1st 24 hrs. Nat. _____
1st 24 hrs. after shot _____
Gas _____ cu. ft. _____
Dry Hole _____
Abandoned _____



Ft. from N. Line

330 Ft. from S. Line

Ft. from E. Line

330 Ft. from W. Line

Elev. 1470

SOUTH

REPORT

1956

3/11	Rotary Ring
------	-------------

3/13

3/20 T.D. 545 Reaming.

3/27 15"-530' Drlg. 1070'

4/2 Drlg. 2555'

4/10 Chat 3291' 8"@3295' T.D. 3307'

4/16 T.D. 3373' S.D.

4/22/36- Chat 3291!

T.D. 3373'

2000 acid.

Flow 338 bbls.

COMPLETED

KANSAS

Map No. 40 Sec. 17 Twp. 24 R. 4W

Well No. 2-Seedle

Sinclair-Prairie Company

Contractor

FIRST REPORTS

Ft. from N. Line

330 Ft. from S. Line

Ft. from E. Line

330 Ft. from W. Line

SECTION PLAT

		0	

Location

Rig up

Drilling and Remarks:

Rotary Rig

RECORD

Cased in., ft.

Sand

Gas

Oil

Total Depth

PRODUCTION

1st 24 hrs. Nat.

1st 24 hrs. after shot

Gas Cu. Ft.

Dry Hole

Abandoned

Date

3-11-36 192

ORVAL MANNSCHRECK Scout

KANSAS

Map No. 40 Sec. 17 Twp. 24 R. 4NWell No. 2 SeecolleSinclair Prairie Company

Contractor

SECTION PLAT

		0	

Ft. from N. Line

330 Ft. from S. Line

Ft. from E. Line

330 Ft. from W. Line

COMPLETED

Location

Rig up

Drilling and Remarks:

Chat 32912000 acidFlow 3388 1/4

RECORD

Cased _____ in., _____ ft.

Sand _____

Gas _____

Oil _____

Total Depth 3323

PRODUCTION

1st 24 hrs. Nat. _____

1st 24 hrs. after shot _____

Gas _____ Cu. Ft.

Dry Hole _____

Abandoned _____

Date

APR 22 1936

192

Scout