


Section 17 Township 24 Range 4-W


Well Number #5 Seedle

Company Sinclair-Prairie

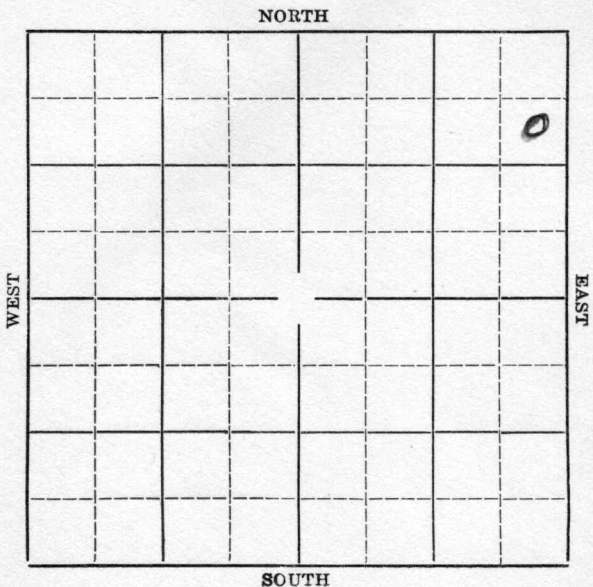

Sec. 17 Twp. 24 R. 4-WWell No. 5 Seedle FarmSinclair-Prairie Company990 Ft. from N. Line Ft. from S. Line330 Ft. from E. Line Ft. from W. Line

Elev. 1471

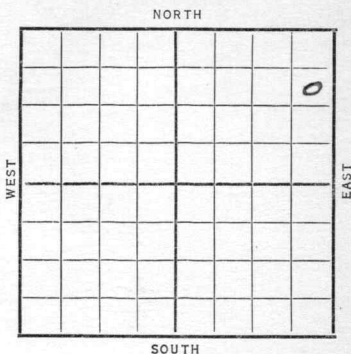~~1936~~

REPORT

11/4 Rig

11/12 15" @ 492. T. D. 509 WOC

11/19 Drlg. 2785'.

11/27 Chat 3283'. 8" @ 3290' WOC

12/3 T. D. 3368'. 2000 acid.

No test.

12/10 563 oil 9 M gas.

5000 acid. No test.

12/16 Chat 3283'. 5000 acid.

T. D. 3368'.

11 M Gas.

1178 Oil.

225 water.

COMPLETED

KANSAS

Map No. 40 Sec. 17 Twp. 24 R. 4WWell No. 5 SeedeSinclair-Prairie Company

Contractor

SECTION PLAT

			0

290 Ft. from N. Line

_____ Ft. from S. Line

330 Ft. from E. Line

_____ Ft. from W. Line

FIRST REPORT

Location _____

Rig up _____

Drilling and Remarks:

Rig

RECORD

Cased _____ in., _____ ft.

Sand _____

Gas _____

Oil _____

Total Depth _____

PRODUCTION

1st 24 hrs. Nat. _____

1st 24 hrs. after shot _____

Gas _____ Cu. Ft.

Dry Hole _____

Abandoned _____

Date

NOV 4 1936

19

S. J. LEWIS Scout

KANSAS

Map No. 40 Sec. 17 Twp. 24 R. 4WWell No. 5 SeecoleSinclair-Prairie Company

Contractor

SECTION PLAT

990 Ft. from N. Line

_____ Ft. from S. Line

330 Ft. from E. Line

_____ Ft. from W. Line

COMPLETED

			0

Location _____

Rig up _____

Drilling and Remarks:

Chat 32835000 acid11M Gas.1175 oil225 water

RECORD

Cased _____ in., _____ ft.

Sand _____

Gas _____

Oil _____

Total Depth 3368

PRODUCTION

1st 24 hrs. Nat. _____

1st 24 hrs. after shot _____

Gas _____ Cu. Ft.

Dry Hole _____

Abandoned _____

Date

DEC 16 1936

19

S. J. LEWIS

Scout