


Section 17 Township 24 Range 4-W

Well Number #6 ~~8~~-Scheutzer

Company McPherson Dlg. et al

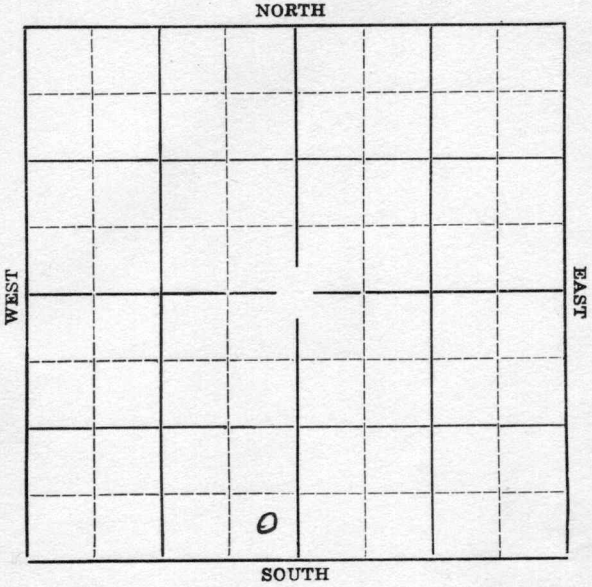

Map No. #6 Sec. 17 Twp. 24 R. 4W

Well No. #6 Scheutzer Farm

McPherson Drlg. et al Company


\_\_\_\_\_ Ft. from N. Line

330' Ft. from S. Line

330' Ft. from E. Line

\_\_\_\_\_ Ft. from W. Line

Elev. 1468

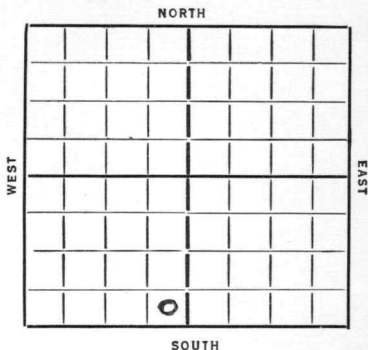

Date	REPORT
1936	
4/29	Cellar.
5/7	Rigging up.
5/14	12" @ 482'. Drlg. 1300(.
5/21	Drlg. 2639&.
5/28	Chat 3308'- 7" @ 3311'. T.D. 3314' Rigging up standard tools.
6/4	T.D. 3375'. Natural flow and pump 544 bbls in 21 hours.
6/10/36	-Chat 3308'. Total depth 3375'. 1000 gallons acid. 1746 bbls oil flow.
	<b>COMPLETED</b>

KANSAS

Map No. 40 Sec. 17 Twp. 24 R. 4N

Well No. 3 Schenutee

W. P. Peterson Drilling & Oil Company

Contractor

SECTION PLAT

..... Ft. from N. Line

330 Ft. from S. Line

330 Ft. from E. Line

..... Ft. from W. Line


FIRST REPORT

Location.....

Rig up.....

Drilling and Remarks:

Cellar

RECORD

Cased..... in., ..... ft.

Sand.....

Gas.....

Oil.....

Total Depth.....

PRODUCTION

1st 24 hrs. Nat.....

1st 24 hrs. after shot.....

Gas..... Cu. Ft.

Dry Hole.....

Abandoned.....

Date

APR 29 1936 192

S. J. LEWIS

Scout

Map No. 40 Sec. 17 Twp. 24 R. 4W

Well No. 6 Schentzer

W. P. Person & Co. Company  
Contractor

**SECTION PLAT**


\_\_\_\_\_ Ft. from N. Line

330 Ft. from S. Line

330 Ft. from E. Line

\_\_\_\_\_ Ft. from W. Line

**CORRECTION**

Location \_\_\_\_\_

Rig up \_\_\_\_\_

Drilling and Remarks:

*Reported as  
No. 3*

**RECORD**

Cased \_\_\_\_\_ in., \_\_\_\_\_ ft.

Sand \_\_\_\_\_

Gas \_\_\_\_\_

Oil \_\_\_\_\_

Total Depth \_\_\_\_\_

**PRODUCTION**

1st 24 hrs. Nat. \_\_\_\_\_

1st 24 hrs. after shot \_\_\_\_\_

Gas \_\_\_\_\_ Cu. Ft.

Dry Hole \_\_\_\_\_

Abandoned \_\_\_\_\_

Date

MAY 6 1936

S. J. LEWIS

Scout

Map No. KANSAS Sec. 17 Twp. 24 R. 4 W

Well No. 6 Schuster

McPherson Drilling & Oil Company  
Contractor

**SECTION PLAT**


\_\_\_\_\_ Ft. from N. Line

330 Ft. from S. Line

330 Ft. from E. Line

\_\_\_\_\_ Ft. from W. Line

**COMPLETED**

Location \_\_\_\_\_

Rig up \_\_\_\_\_

Drilling and Remarks:

Chas 3308.  
1000 acid  
1746 Flow.

**RECORD**

Cased \_\_\_\_\_ in., \_\_\_\_\_ ft.

Sand \_\_\_\_\_

Gas \_\_\_\_\_

Oil \_\_\_\_\_

Total Depth 3325

**PRODUCTION**

1st 24 hrs. Nat. \_\_\_\_\_

1st 24 hrs. after shot \_\_\_\_\_

Gas \_\_\_\_\_ Cu. Ft.

Dry Hole \_\_\_\_\_

Abandoned \_\_\_\_\_

Date

JUN 10 1936

S. J. LEWIS Scout