FORM 51 10M 7-48 PETROL


KANSAS Stafford

Section 17 Township 24 Range 12W

Well No. 1 Marie McMillan

Company Musgrove Pet. et al

Wildcat

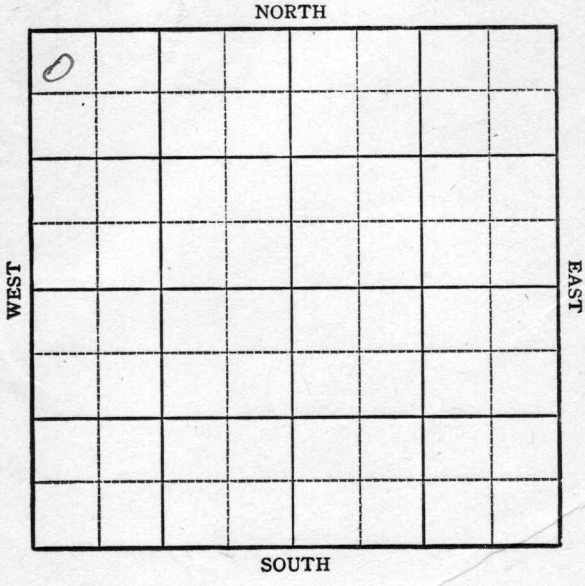

FORM 252-A
5M 4-46 PETROL

HOT FILE KANSAS Stafford

Sec. 17 Twp. 24 R. 12W

Well No. #1 McMillan Farm


Musgrove Company

330 Ft. from N. Line

Ft. from S. Line

Ft. from E. Line

330 Ft. from W. Line

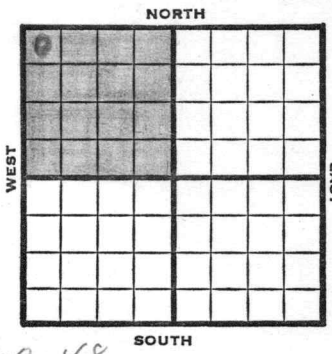


Letter to Sdy-on 10-7-48

1948 Elev 1886 REPORT

| | | |
|---|---|---|
| 9/21 | Spudded 9-20-48<br>Set 385' 8-5/8" pipe.<br>WOC. | (Wichita office) |
| 9/22 | WOC. | (Musgrove) |
| 9/23 | Drilling 1145' | (Musgrove) |
| 9/24 | Drilling at 1875' | (Musgrove) |
| 9/25 | Drilling at 2245' | (Musgrove) |
| 9/27 | Drilling at 2925' | (Musgrove) |
| 9/28 | Drilling at 3245' | (Musgrove) |
| 9/29 | Drilling 3490' | (Musgrove) |
| 9/30 | Drilling at 3582'<br>Top Kansas City 3498' | (Musgrove) |
| 10/1 | Drilling 3680' | (Musgrove) |
| 10/4 | Top Viola 3876'<br>DST. on 3rd of Oct.<br>3879'-3911'<br>Rec. 80' gas cut mud<br>Drilling 3954' | (Musgrove) |
| 10/5 | Drilling at 4065' | (Musgrove) |
| 10/5 | From Ticket (Scout)<br>Spudded 9-20-48<br>8 5/8" @ 385'<br>TD 4116<br>Lans 3498'<br>Cong 3853'<br>Viola 3876'<br>Simps 4003<br>A rb. 4065<br>Aband. | ABANDONED |

Form 26 200 Bks. 9-48 Petrol

Kansas Wildcat

Map No. ____ Sec. 17 Twp. 24 R. 12W

Well No. 1 Marie McMillan


Musgrove Pet. etal. Company

FIRST REPORT

Contractor

NW/C

SECTION PLAT

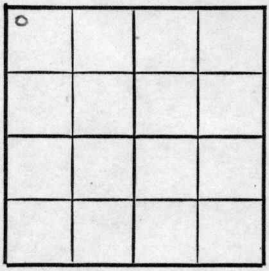

330 Ft. from N. Line

Ft. from S. Line

Ft. from E. Line

330 Ft. from W. Line

Stafford County

Location

Rig up

Drilling and Remarks:

Spudded 9-20-48
8 5/8" @ 385

RECORD

Cased ____ in., ____ ft.

Sand

Gas

Oil

Total Depth

PRODUCTION

1st 24 hrs. Nat.

1st 24 hrs. after shot

Gas ____ Cu. Ft.

Dry Hole

Abandoned

Date

SEP 22 1948 19

S. J. LEWIS Scout

Form 26 200 Bks. 9-48 Petrol

Kansas

Wildcat

Map No. 47 Sec. 17 Twp. 24 R. 12W

Well No. 1 Marie McMillan

Musgrove Pet. etal. Company

ABANDONED Contractor

NW/C


330 Ft. from N. Line

Ft. from S. Line

Ft. from E. Line

330 Ft. from W. Line

SECTION PLAT

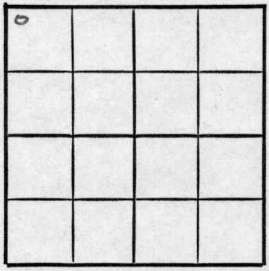

Stafford County

Location

Rig up

Drilling and Remarks:

Lans. 3498
Cong. 3853
Viola 3876
Simp. 4003
Arb. 4065

RECORD

Cased in., ft.

Sand

Gas

Oil

Total Depth 4116

PRODUCTION

1st 24 hrs. Nat.

1st 24 hrs. after shot.

Gas Cu. Ft.

Dry Hole

Abandoned

Date

OCT 6 1948 19 S. J. LEWIS Scout