Stafford

KANSAS


SECTION 17 TOWNSHIP 24 RANGE 12W

WELL NO. #1 Brensing

COMPANY W.J. Coppinger

NORTH

NW NW NE

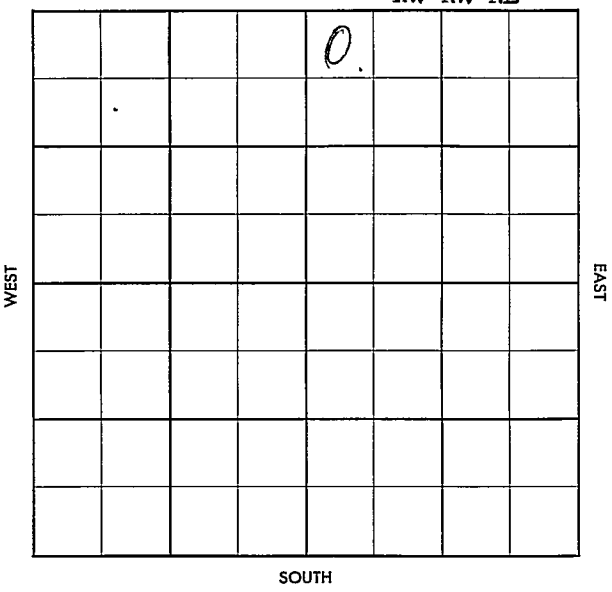

FORM 504-3 SUNRAY

WILDCAT

FORM 513 SUNRA

County Stafford Elev.

Sec. 17 Twp. 24 Rge. 12W

Company W. A. Coppinger

Farm Name Frensing No. 1

TOPS	DEPTH	LOG	DATUM
Anh.			
Tp.			
H.			
Tr.			
Dg.			
Bl.			
L.			
K.C.			
B.K.C.			
Ce.			
C.			
M.			
M.			
K.			
Mz.			
Mq.			
V.			
S.			
S.			
A			
R.			
P€.			
G.			
T.D.			


Loc. in Sec. NW NW NE

(1150' Arb)

Geol.

Contr. Rex & Morris

Pool Wildcat

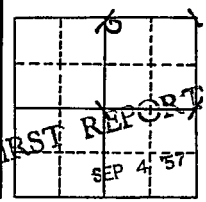

Date Comm. Osage & Carter - DHM

MIRT

Co. Lse. No. Sec. T. R.

FORM 513 SUNRAY

County Stafford Elev. Est. 1998 D.F

Sec. 17 Twp. 24 Rge. 12W

Company W. J. Coppinger

Farm Name Brensing No. 1

TOPS	DEPTH	LOG	DATUM
Anh.			
Tp.			
H.	3322		
Tr.			
Dg.			
Bl.	3477		
L.	3506		
K.C.			
B.K.C.			
Ce.			
C.			
M.			
M.			
K.			
Mz.			
Mo.			
V.	3872		
S.			
S.			
A			
R.			
P€.			
G.			
T.D.	3877		

Loc. in Sec. NW NW NE (4150' Arb)

Geol.

Contr. Rex & Morris

Pool KNOCK

~~Wildcat~~

COMPLETE OCT 30 '57

Date Comm. Osage & Carter - DHM

MIRT SEP 11 '57 9-3 & 36 6/25

TD 3620 SEP 18 '57 DST 3870-77

1hr GTS 1/2" in 2040' oil 260'

M'CO 30' $1.06 GCM FP 40-450

BHP 1050 5# 3872

SEP 25 '57 CO 3877 & 7½ BOPH

WOW 1500' off Bott POP

OCT 2 '57 P 100 BOPD + 1120 W

at surface WO POT

FORM 513-1 SUNRAY

OCT 9 '57 → OCT 16 '57 – X OCT 31 '57 X

Taking Pot today OCT 30 '57 X

PH4 1398O +11% W 24hrs

40° gr

Viola Open Hole 3572-3627

17-24-12W-1 NW NW NE