


DX 78-1 **Stafford**

KANSAS

Section 17 Township 24 Range 12W

Well No. #1 A. Byer

Company Anschutz Drlg

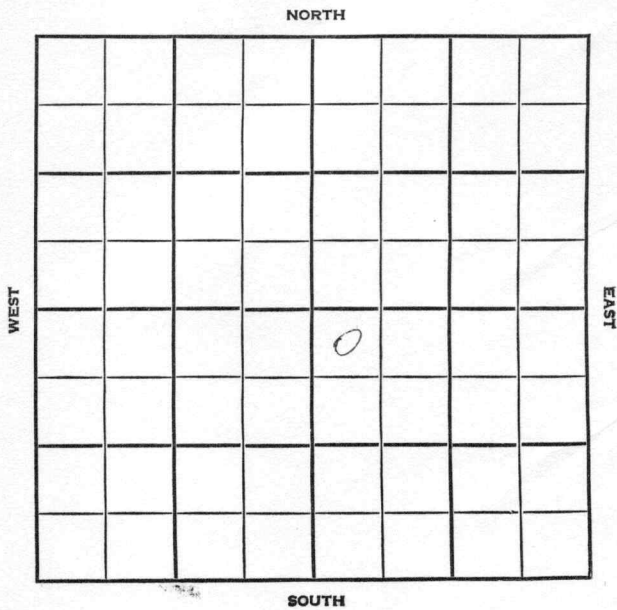

County Stafford Elev. _____
 Sec. 17 Twp. 24 Rge. 12W
 Company Anschutz Drlg.
 Farm Name A. Byer No. 1

TOPS	DEPTH	LOG	DATUM
------	-------	-----	-------

Anh.	695		
Tr.			
H.			
Tr.			
Dg.			
BL.			
L.			
K.C.			
B.K.C.			
Ce.			
C.			
M.			
M.			
K.			
Mz.			
Mo.			
V.			
S.			
S.			
A.			
R.			
PE.			
G.			
T.D.			

Loc. in Sec. _____

NW NW SE

Geol. _____

Contr. _____

Co. tools

Pool

Wildcat

FIRST REPORT

JUL 25 1956

Date Comm. 7-19-56 Carter & Lion - DDM
Sinclair - support
88 @ 246/175 drlg. 2815



Co.

County Stafford Elev. 1887
 Sec. 17 Twp. 24 Rge. 12W
 Company Anschutz Drle.
 Farm Name A. Byer No. 1

TOPS	DEPTH	LOG	DATUM	Loc. in Sec.
Anh.	695			NW NW SW
TP.				
H.	3327			
Tr.				
Dg.				
BL.	3480			
L.	3510			
K.C.				Geol.
B.K.C.	3777			Contr.
Ce.				So. tools
C.	3828			Kanacoh S.
M.				Pool
M.				Wildcat
K.				
Mz.				
Mq.				
V.	3884			
S. <u>36</u>	4019			
S.				
A.	4088			
R.				
PE.				
G.				
TD.	4130			

Lse.

No.

Sec.

T.

R.

Date Comm. 7-19-56Center & Lion - Drle.
Sinclair - suppor8H @ 216/175 drle. 2815 AUG 1 '56 X

DST 3884-91 1hr gas in 17"
see 70' 0' GCM + 960' oil + 245'
0' GCSW FP 140-540 BHP 1080/20"
DST 3932-39 1hr 240' 50' GCSW
BHP 1110/
AUG 8 5 1/2 @ 3928
1100 CO 5/3884-85 1 1/2 G-0
+ Rot Md 50 gal acid FU 80
G-0 in 12 hrs PF 3885-86

ABANDONED

OCT 3 '56

AUG 15 '56

4/3885-86 B 19 Goph
 + Tr. Wtr 4/3886-87 \$ 8³/₄
 B0 + 3¹/₄ BW 1¹/₄ + 1st wtr
 56d PF 3885-87 CO

AUG 24 '56

CO RePF 8/3884-86
 B 17 Gwph + 2 Goph
 \$.58 B0 + 2.91 BW in
 4 hrs 1³/₄ \$ 25 BFph
 mostly wtr to 56
 CO RePF 8/3884-86 50

AUG 29 '56

gal acid 5.1. 12 hrs 550
 1¹/₄ \$ 15 BFph 65% w
 4 hrs POP SEP 5 '56 POP SEP 12 '56

P. 32.64 B0 + 143 BW
 in 14 hrs P. 10¹/₂ B0
 + ~~7~~ wtr 24 hrs SEP 19 '56 P.

7 B0 + 351 BW 24 hrs
 SEP 26 '56 P. 8.12 B0 + 385 BWpd
 W.00. OCT 3 '56 P. 208 B0 +
 5773 BW in 20 days.

D&A

17-24-12W

mw mw mw