


Section 17 Township 24 Range 13-W

Well No. 1 R. S. Shank

Company Stanolind

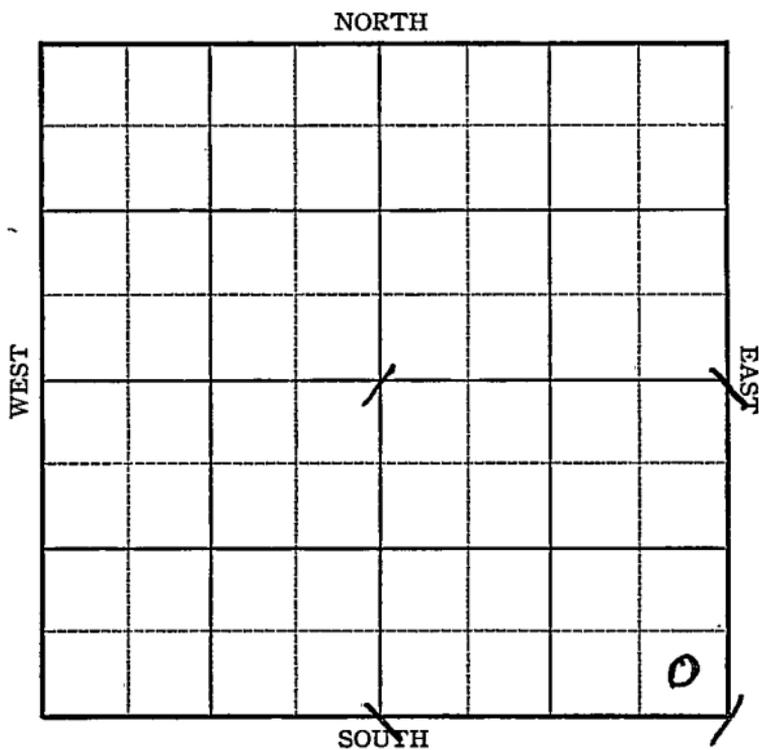

Stafford KANSAS

Map No. 83 Sec. 17 Twp. 24 R. 13W

Well No. I R. S. Shank

Stanolind

Company

Contractor

ABANDONED

SE/C

SECTION PLAT

_____ Ft. from N. Line

			0

330 Ft. from S. Line

330 Ft. from E. Line

_____ Ft. from W. Line

Location _____

RECORD

Rig up _____

Cased _____ in., _____ ft.

Drilling and Remarks:

Sand sil 4117

Gas _____

Oil _____

Total Depth 4145

Viola Lime 4025

PRODUCTION

sulphur water in core

1st 24 hrs. Nat. _____

1st 24 hrs. after shot _____

Gas _____ Cu. Ft.

Dry Hole _____

Abandoned _____

DYA

Date

NOV 10 1937

19

H. D. Hatfield Scout