
DX 78-1 Stafford KANSAS

Section 17 Township 24 Range 14W

Well No. #1 Laudrick

Company Anschutz

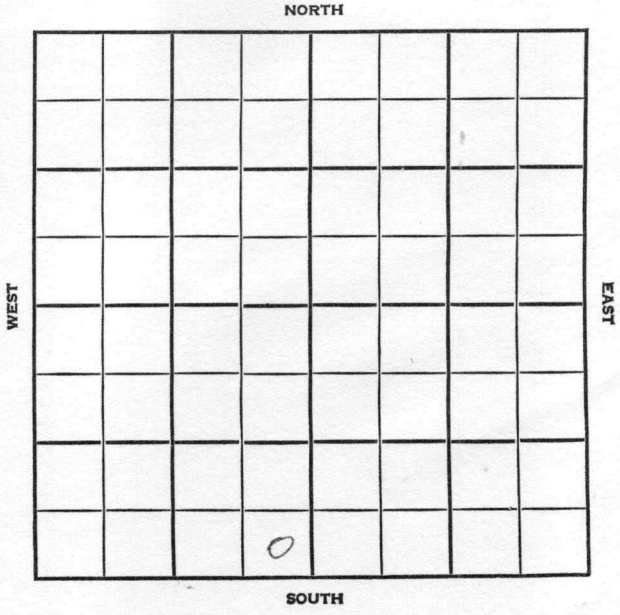

Stafford KANSAS

SEC.	TWP.	R.
17	24	14W

WELL NO. #1 Laudrick FARM

COMPANY Anschutz

CONTRACTOR Co. Tools

Dillwyn Ext.


_____ FT. FROM N. LINE

_____ FT. FROM S. LINE

_____ FT. FROM E. LINE

_____ FT. FROM W. LINE

SE SE SW

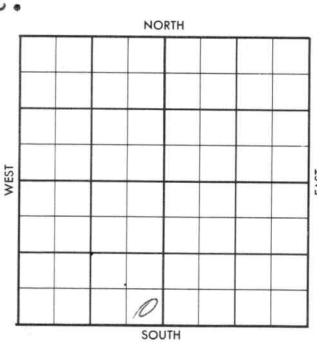

SDX - ½ mile.

1956 ELEVATION 1984' REPORT

7-3 MIR

7-12 Spud 7-3-56
8 5/8" @ 278 w/175
Drlg. 3345

7-19 Miss. 4081, ### Viola 4171
DST 3820-36, op 1 hr, rec. 60' mud, 340/20".
DST 4106-36, op 1 hr, rec. 10' mud, 0#
Drlg. 4191'

7-25 DST 4327-38, op 1 hr . rec. 20' oil ≠ 150' O&WCM ≠ 60' MW ≠ 120' sulp. wtr. BHP 1360#.
D & A
H. 3541'; BL. 3683'; L. 3700';
M. 4081'; V. 4171'; S. 4269';
A. 4329';
TD 4349';

ABANDONED

FORM 513 SUNRAY

County Stafford Elev.

Sec. 17 Twp. 24 Rge. 11W

Company Anschutz

Farm Name Laudrick No. 1

TOPS	DEPTH	LOG	DATUM
Anh.			
Tp.			
H.			
Tr.			
Dg.			
B.L.			
L.			
K.C.			
B.K.C.			
Ce.			
C.			
M.			
M.			
K.			
Mz.			
Mo.			
V.			
S.			
S.			
A			
R.			
P€.			
G.			
T.D.			

Loc. in Sec. SE SE SW

Geol.

Contr. Co. tools

Pool Laudrick Dillwyn Ext.

½ mile

FIRST REPORT

JUL 3 '58

0

Date Comm. M I R

Co. Lse. No. Sec. T. R.

FORM 513 SUNRAY

County Stafford Elev. 1784

Sec. 17 Twp. 24 Rge. 11W

Company Inselmutz

Farm Name Laudrick No. 1

	DEPTH	LOG	DATUM
T.			
H.	3541		
Tr.			
Dg.			
Bl.	3683		
L.	3700		
K.C.			
B.K.C.			
Ce.			
C.			
M.	4081		
M.			
K.			
Mz.			
Mo.			
V.	4171		
S.	4269		
S.			
A	4329		
R.			
Pe.			
G.			
T.D.	4349		

Loc. in Sec. SE SE SW

Geol.

Contr. Co. tools

Pool Millwyn Ext.

Atlantic

ABANDONED

JUL 25 1956

Date Comm. NCRA DHM

MIR JUL 11 '56 7-3-56 8 5/8 278

1175 ℗ 3345 JUL 18 '56

DST 3820-36 1hr rec 60' Md

(SSO) 340/20# DST 4106-36

1hr rec 10' Md BHP 0 ℗ 4191

JUL 25 '56 DST 4327-38 ℗ 1hr rec

20' oil + 150' O&EWCM + 60' MW

+ 120' sulpwtr BHP 1360

D&A

Co. Lse. No. Sec. T. R.