

Finney


KANSAS

SECTION 17 TOWNSHIP 24 RANGE 31W

WELL NO. #1 Morris "D"

COMPANY Petroleum Inc.

NORTH

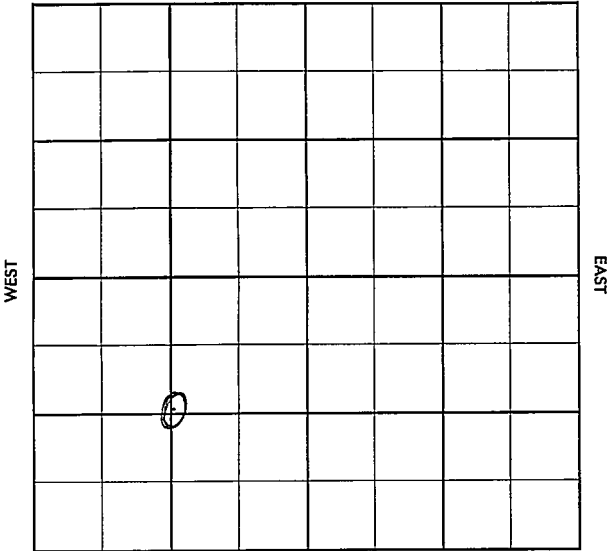

SOUTH

County Finney Elev. \_\_\_\_\_  
 Sec. 17 Twp. 21 Rge. 31W  
 Company Petroleum Inc.  
 Farm Name Morris "D" No. 1

TOPS	DEPTH	LOG	DATUM
Anh.			
Tp.			
Herr.	2611		
Tr. Kri.	2631		
Dg.			
Bl.			
L.			
K.C.			
B.K.C.			
Ce.			
C.			
M.			
M.			
K.			
Mz.			
Me.			
V.			
S.			
S.			
A.			
R.			
PE.			
G.			
T.D.	2646		

Loc. in Sec. C SW/4  
 Geol. \_\_\_\_\_  
 Contr. \_\_\_\_\_  
Garvey  
 Pool Hugoton


FIRST REPORT  
 JAN 3 '57

Date Comm. 12-26-56  
8" @ 540/350 5" @ 2611/650

~~35~~

Co.  
 Lse.  
 No.  
 Sec.  
 T.  
 R.

County Finney Elev. 2906  
 Sec. 17 Twp. 24 Rge. 31W  
 Company Petroleum Inc.  
 Farm Name Morris "D" No. 1

Co.

TOPS	DEPTH	LOG	DATUM
Anh.			
TP.			
H. err.	2611		
Tr. Km.	2634		
Dg.			
Bl.			
L.			
K.C.			
B.K.C.			
Ce.			
C.			
M.			
M.			
K.			
Mz.			
Ma.			
V.			
S.			
S.			
A.			
R.			
PE.			
G.			
T.D.	2616		

Loc. in Sec. C SW/4  
 Geol. \_\_\_\_\_  
 Contr. \_\_\_\_\_  
Garvey  
 Pool \_\_\_\_\_  
Hugoton

Use.

**COMPLETE**  
 FEB 27 '57

No.

Date Comm. 12-26-56

Sec.

8" @ 540/350 5" @ 2611/650

W OCT JAN 13 '57 ✓

FEEL CO 2643 16' 2605-09

26/2618-27 12/2638 1/2 - 41 1/2

103  
 MCF FVAC 92 #1220 MCF GPP

CB 10 '57 50d 2638-41 92 420 MCF

+ 7 Gwph FVAC 6x4 FEB 20 '57 92

638 MCFw 72-20 92 1,377

MCFw 51P 425.2

T.

R.