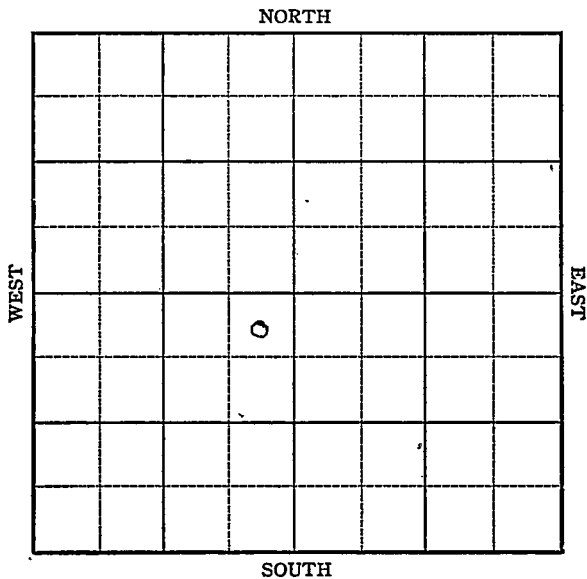


KANSAS

Finney county

Section 17 Township 24 Range 34-WWell No. #1, Flotonkous (Fotopoulos)Company Champlin Refg.

KANSAS

Finney ✓

Sec. 17 Twp. 24 R. 34W

Well No. #1 Flotonkous Farm

Champlin Ref. Company


Hugoton

330 Ft. from N. Line

 Ft. from S. Line

330 Ft. from E. Line

 Ft. from W. Line

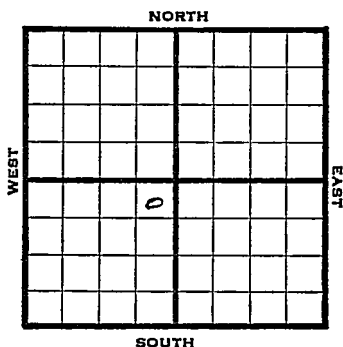

NE SW

REPORT

1946

10/9 Location

10/15 "

10/23 Location Abandoned

ABANDONED

KANSAS

Kansas Hugoton

Map No. _____ Sec. 17 Twp. 24 R. 34WWell No. 1 Flotopkous

_____ Champlin Ref. _____ Company

FIRST REPORT

Contractor _____

NE SW

SECTION PLAT

330 Ft. from N. Line

_____ Ft. from S. Line

330 Ft. from E. Line

_____ Ft. from W. Line

		o	

Finney County

Location X

Rig up _____

Drilling and Remarks:

RECORD

Cased _____ in., _____ ft.

Sand _____

Gas _____

Oil _____

Total Depth _____

PRODUCTION

1st 24 hrs. Nat. _____

1st 24 hrs. after shot _____

Gas _____ Cu. Ft.

Dry Hole _____

Abandoned _____

Date

OCT 9 1946 19 S. J. LEWIS Scout

Map No. _____ Sec. 17 Twp. 24 R. 34W

Well No. 1 Flotophous

Champlin Ref. _____ Company _____

ABANDONED

Contractor _____

NE SW

SECTION PLAT

330 Ft. from N. Line

_____ Ft. from S. Line

330 Ft. from E. Line

_____ Ft. from W. Line

Finney County

Location ✓

Rig up _____

Drilling and Remarks:

RECORD

Cased _____ in. _____ ft.

Sand _____

Gas _____

Oil _____

Total Depth _____

PRODUCTION

1st 24 hrs. Nat. _____

1st 24 hrs. after shot _____

Gas _____ Cu. Ft.

Dry Hole _____

Abandoned _____

Date

OCT 23 1946

19

S. J. LEWIS

Scout