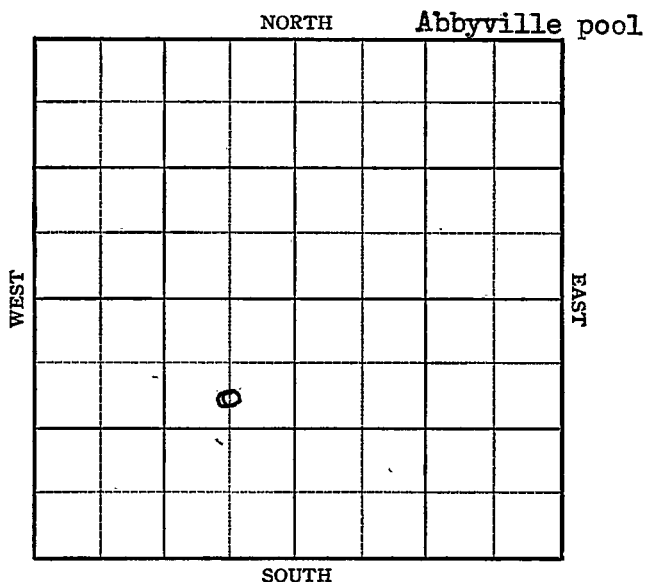


KANSAS

Reno Co.

Section 18 Township 24 Range 7WWell No. #1 WarnackCompany Petroleum Inc.

Reno

KANSAS

Sec. 18 Twp. 24 R. TW ✓

Well No. #1 Warnack Farm

Petroleum, Inc. Company

Abbyville Pool


990' Ft. from N. Line

 Ft. from S. Line

660' Ft. from E. Line

 Ft. from W. Line

C S L NE SW

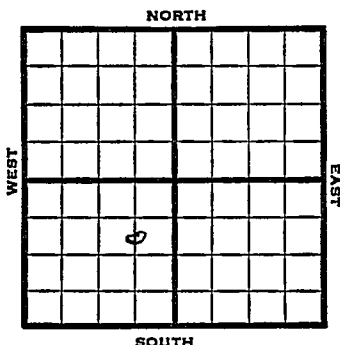

1949 Elev 1631' REPORT

8/17 RUR

8/24 8" @ 193'
Drlg. 1565'

8/31 Drlg 3048'

9/7 TD 3521'
5" @ 3521'

9/14 TD 3521'
Lansing 3181'
5" @ 3512'
500 acid
Pump 30 Oil Pot
38° Gr.
Comp

3181
1631
1550

COMPLETED

Kansas

Map No. _____ Sec. 18 Twp. 24 R. 7W

Well No. 1 Warnack

Petroleum Inc.

Company

Contractor

C S L NE SW


FIRST REPORT
SECTION PLAT

990 Ft. from N. Line

Ft. from S. Line

660 Ft. from E. Line

Ft. from W. Line

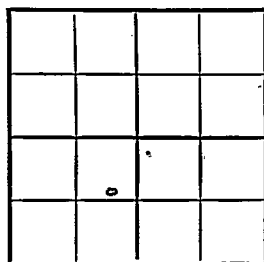

Reno County

RECORD

Location _____

Cased _____ in. _____ ft.

Rig up _____

Sand _____

Drilling and Remarks:

Gas _____

Oil _____

Total Depth _____

R U R

PRODUCTION

1st 24 hrs. Nat. _____

1st 24 hrs. after shot _____

Gas _____ Cu. Ft.

Dry Hole _____

Abandoned _____

Date

AUG 17 1949 19 S. J. LEWIS Scout

Map No. K41 Sec. 18 Twp. 24 R. 7W

Well No. 1 Warnack

Petroleum, Inc. Company

COMPLETE

Contractor

C S L NE SW


E1.1681
SECTION PLAT

990 Ft. from N. Line

 Ft. from S. Line

660 Ft. from E. Line

 Ft. from W. Line

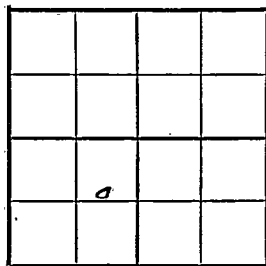

Reno County

Location

Rig up

Drilling and Remarks:

Lane 3187
5-11 @ 35 1/2
5000 cu ft
Only 3000 ft
88° E

RECORD

Cased in., ft.

Sand

Gas

Oil

Total Depth 2521

PRODUCTION

1st 24 hrs. Nat.

1st 24 hrs. after shot

Gas Cu. Ft.

Dry Hole

Abandoned

Date

SEP 14 1949

19

S. J. LEWIS

Scout