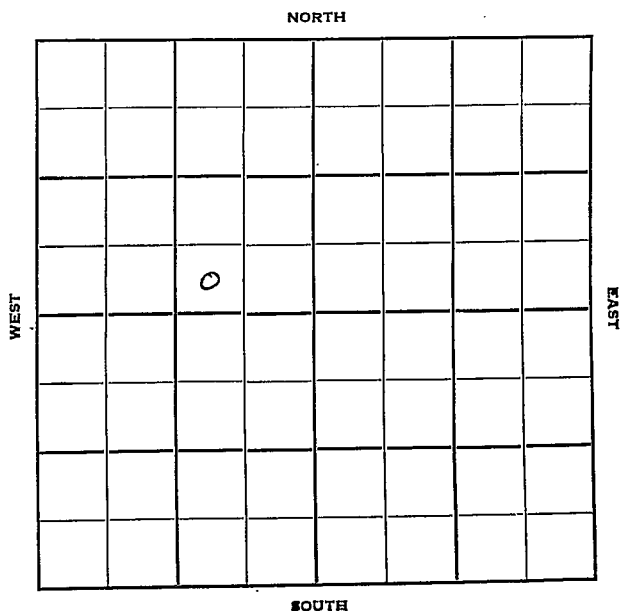


KANSAS

Reno

Section 18 Township 24S Range 7WWell No. #1 EvansCompany Petroleum Inc.

KANSAS Reno

Sec. 18 Twp. 24 R. 7-W ✓

Well No. #1 Evans Farm

Petroleum Inc. Company

Abbeyville


 Ft. from N. Line

330 Ft. from S. Line

990 Ft. from E. Line

 Ft. from W. Line

SW SE NW

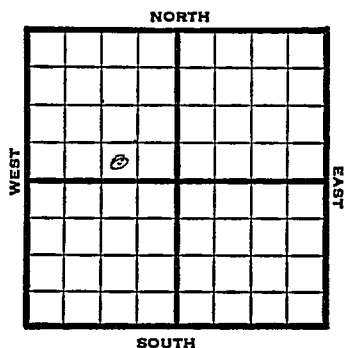

1949

Elev 1627' REPORT

10/5

8" @ 193'

10/12

Drlg 2856'

10/19

TD 3660'

Lansing 3178'

Aband.

ABANDONED

Kansas

Abbeyville Pool

Map No. _____ Sec. 18 Twp. 24 R. 7W

Well No. 1 Evans

Petroleum Inc.

Company

Stag

Contractor

SW SE NW

FIRST REPORT
SECTION PLAT

Ft. from N. Line

330

Ft. from S. Line

990

Ft. from E. Line

Ft. from W. Line

Reno County

Location

Rig up

Drilling and Remarks:

8" @ 193

RECORD

Cased _____ in., _____ ft.

Sand _____

Gas _____

Oil _____

Total Depth _____

PRODUCTION

1st 24 hrs. Nat. _____

1st 24 hrs. after shot _____

Gas _____ Cu. Ft.

Dry Hole _____

Abandoned _____

Date

OCT 5 1949

19

S. J. LEWIS

Scout

Map No. _____ Sec. 18 Twp. 24 R. 7W

Well No. 1 Evans

Petroleum Inc. Company

ABANDONED

Contractor

SW SE NW

E11627
SECTION PLAT

	6		

_____ Ft. from N. Line

330 Ft. from S. Line

990 Ft. from E. Line

_____ Ft. from W. Line

Reno County

Location _____

Rig up _____

Drilling and Remarks:

Land 3175.

RECORD

Cased _____ in., _____ ft.

Sand _____

Gas _____

Oil _____

Total Depth 2660

PRODUCTION

1st 24 hrs. Nat. _____

1st 24 hrs. after shot _____

Gas _____ Cu. Ft.

Dry Hole _____

Abandoned _____

Date

OCT 19 1949

19

S. J. LEWIS

Scout