


Section 18 Township 24 Range 7W

Well No. #2 #12 Heter

Company Geo. Seigris

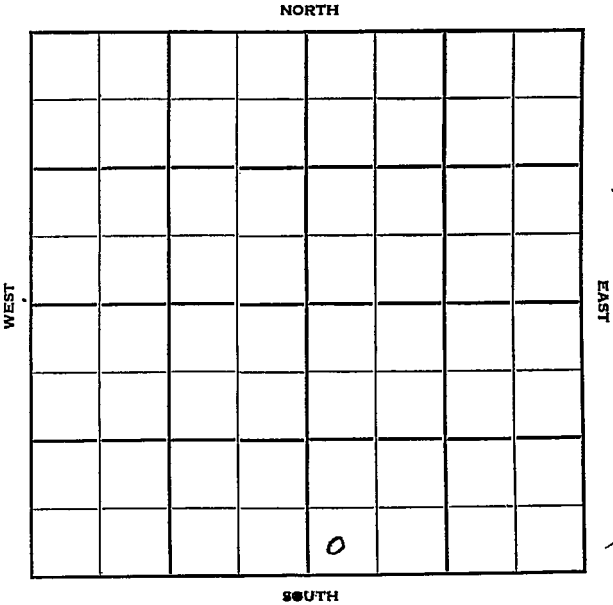

KANSAS

Reno

Sec. 18 Twp. 24 R. 7W

Well No. #2 ~~#1~~ Heter Farm

Geo. Seigrist Company

Buick - Contr. Contractor

Abbeyville Pool


 Ft. from N. Line

330' Ft. from S. Line

 Ft. from E. Line

330' Ft. from W. Line

SW SW SE

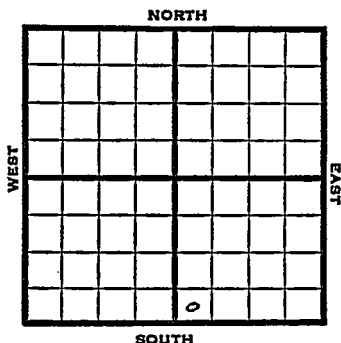

1951

Elev. 1630' REPORT

5/2

Spud 4-30-51
Drlg.

6/13

Spud 4-30-51
Oil Well TD 3512
8" @ 168
Br Lime 3160 Lans. 3182 3182
TD 3512 5" @ 3511
Comp. 60 bopd

COMPLETED

J. E. TYRA

Kans.

Map No. _____ Sec. 18 Twp. 24 R. 7W

Well No. 2 Heter

Geo. Seigrist Company

CORRECTION

Contractor

SW SW SE (twin well)

SECTION PLAT

_____ Ft. from N. Line

330 Ft. from S. Line

_____ Ft. from E. Line

330 Ft. from W. Line

		0	

Reno County

RECORD

Location _____

Cased _____ in., _____ ft.

Rig up _____

Sand _____

Drilling and Remarks:

Gas _____

Reported

Oil _____

#1 Heter

Total Depth _____

PRODUCTION

1st 24 hrs. Nat. _____

1st 24 hrs. after shot _____

Gas _____ Cu. Ft.

Dry Hole _____

Abandoned _____

Date

MAY 16 1951

J. E. TYRA

19

Scout

J. E. TYRA