FORM 51 10M 7-48 PETROL

KANSAS


Reno

Section 18 Township 24 Range 7W

Well No. 1 Warnock

Company Geo. Seigrist et al

Abbey Pool

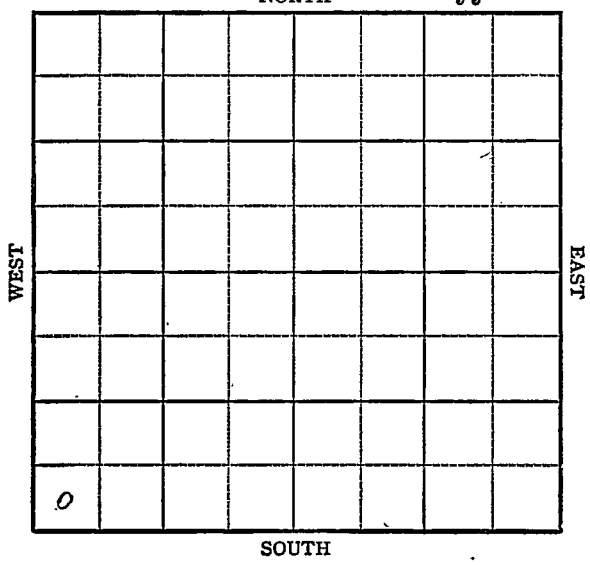

FORM 252-A.
5M 10-48 PETROL

KANSAS

Reno

Sec. 18 Twp. 24 R. 7W ✓

Well No. #1 Warnock Farm

Geo. Seigrist et al Company

Abbey Pool


_____ Ft. from N. Line

330' Ft. from S. Line

_____ Ft. from E. Line

330' Ft. from W. Line

SW/C

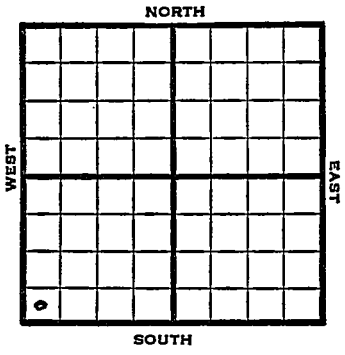

1948	Elev. 1632' REPORT
12/15	8" @ 193' Pay Sd 3420-23 TD 4" @ 3521'
12/22	"
12/29	Lansing 3519'
1/5	500@cid flow
1/12	500 acid sw & 10 bbls oil PH
1/19	"
1/26	Lans. 3182' 4" @ 3521' 1000 acid Pump 75 oil Pot. Gr. 38° TD 3523' COMPLETED

Form 26 200 Bks. 9-48 Petrol

Kansas

Abbey Pool

Map No. ____ Sec. 18 Twp. 24 R. 7W


Well No. 1 Warnock

Geo. Seigrist etal. Company

FIRST REPORT Contractor

SW/C

SECTION PLAT

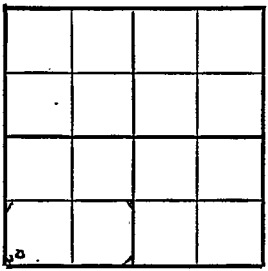

____ Ft. from N. Line

330 Ft. from S. Line

____ Ft. from E. Line

330 Ft. from W. Line

Reno County

Location ____

Rig up ____

Drilling and Remarks:

8" @ 193

Pay 3520-23 ED

4" @ 3521

RECORD

Cased ____ in., ____ ft.

Sand ____

Gas ____

Oil ____

Total Depth ____

PRODUCTION

1st 24 hrs. Nat. ____

1st 24 hrs. after shot ____

Gas ____ Cu. Ft.

Dry Hole ____

Abandoned ____

Date

DEC 15 1948 19 ____

S. J. LEWIS Scout

Form 26 200 Bks. 9-48 Petrol

Kansas

Abbey Pool

Map No. 41 Sec. 18 Twp. 24 R. 7W

Well No. 1 Warnock


Geo. Seigrist etal. Company

COMPLETE Contractor

SW/C

E.1/632

SECTION PLAT

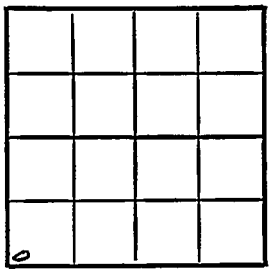

Ft. from N. Line

330 Ft. from S. Line

Ft. from E. Line

330 Ft. from W. Line

Reno County

Location

Rig up

Drilling and Remarks:

Hans 3152

4" @ 3522

100 sacks

Pump 75 bbl P.D.

3824

RECORD

Cased in., ft.

Sand

Gas

Oil

Total Depth 3525

PRODUCTION

1st 24 hrs. Nat.

1st 24 hrs. after shot

Gas Cu. Ft.

Dry Hole

Abandoned

Date

JAN 26 1949 19 S. I. LEWIS Scout