

KANSAS

FORM 51 5M 4-41 PETROL

Reno

Section 18 Township 24 Range 10-W

Well No. 1 Kanatzer

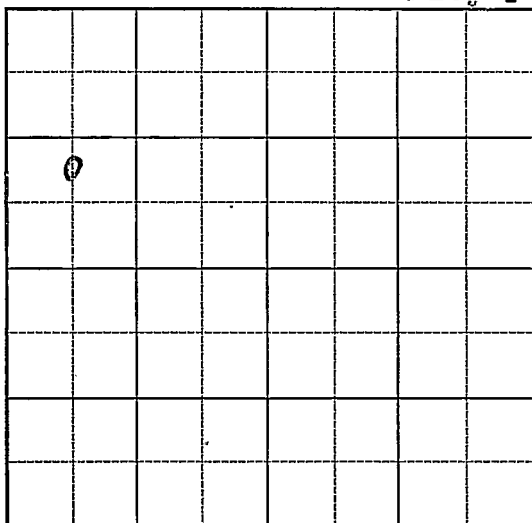
Company Cities Service Oil

NORTH

Zenith pool

WEST

EAST



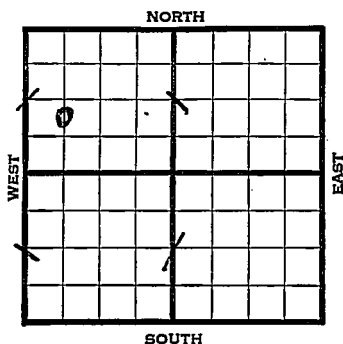
SOUTH

Sec. 18 Twp. 24 R. 10-WWell No. #1 Kanatzer Farm

Cities Service Oil

Company

(Zenith)

 Ft. from N. Line990 Ft. from S. Line Ft. from E. Line660 Ft. from W. Line

Elev. 1788

1941

REPORT

10/1

Drlg. 110'

10/9

10" - 190' Drlg. 3000'

10/16

Misener 3800' Viola 3807-12'

T.D. 3812' S.W.

Shut down.

10/22

Viola 3807'

T.D. 3842'

No shows.

ABANDONED

Map No. K-47 Sec. 18 Twp. 24 R. 10WWell No. 1 KanatzerCities Service Oil Company

Contractor

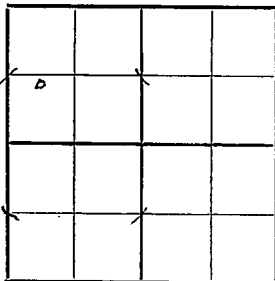
FIRST REPORT

C NL SW NW

 Ft. from N. Line990 Ft. from S. Line Ft. from E. Line660 Ft. from W. Line

ZENITH POOL

SECTION PLAT

Location Rig up

Drilling and Remarks:

Drlg. 110'

RECORD

Cased in., ft.Sand Gas Oil Total Depth

PRODUCTION

1st 24 hrs. Nat. 1st 24 hrs. after shot Gas Cu. Ft.Dry Hole Abandoned

Date

OCT 1 1941S. J. LEWIS Scout

Reno

KANSAS

Map No. K-47 Sec. 18 Twp. 24 R. 10WWell No. 1 KanatzerCities Service Oil CompanyABANDONED Contractor

C NL SW NW

SECTION PLAT

b			

 Ft. from N. Line990 Ft. from S. Line Ft. from E. Line .660 Ft. from W. Line

ZENITH POOL

Location Rig up

Drilling and Remarks:

*Vista 3807**No show*

RECORD

Cased in., ft.Sand Gas Oil Total Depth 3842

PRODUCTION

1st 24 hrs. Nat. 1st 24 hrs. after shot Gas Cu. Ft.Dry Hole Abandoned

Date

OCT 22 1941 19S. J. LEWIS Scout