

KANSAS

Reno

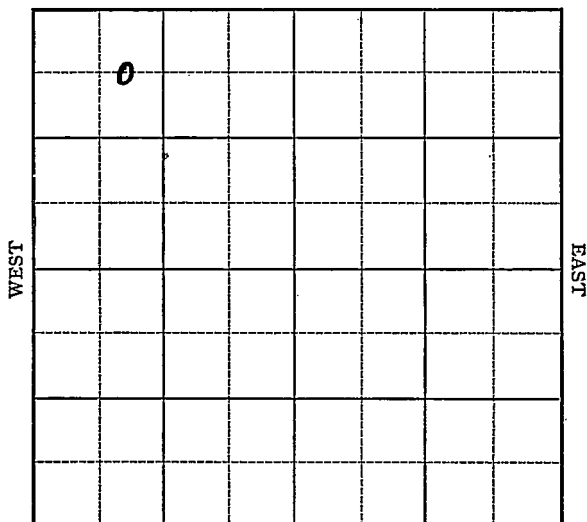
FORM 51 SM 4-41 PETROL

Section 18 Township 24 Range 10-W

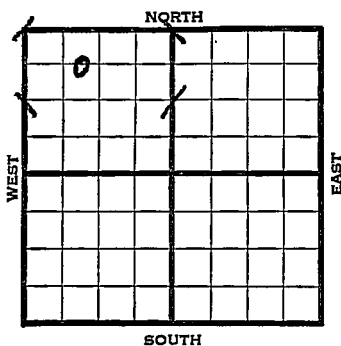
Well No. 2 Hunter

Company Dienes et al

NORTH Zenith Pool



SOUTH

[illegible]

Map No. 47 Sec. 18 Twp. 24 R. 10WWell No. 2 Hunter

Dienes et al

Company

FIRST REPORT

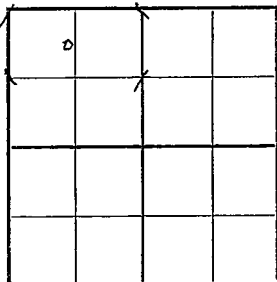
Contractor

C E L NW NW

SECTION PLAT

660 Ft. from N. Line Ft. from S. Line Ft. from E. Line990 Ft. from W. Line

ZENITH POOL

Location Rig up Drilling and Remarks:

Cellar

RECORD

Cased in., ft.Sand Gas Oil Total Depth

PRODUCTION

1st 24 hrs. Nat. 1st 24 hrs. after shot Gas Cu. Ft.Dry Hole Abandoned

Date

AUG 27 1941

19

S. J. LEWIS Scout

Reno

KANSASMap No. K-47 Sec. 18 Twp. 24 R. 10WWell No. 2 HunterDienes et al Company**COMPLETED**

Contractor

C EL NW NW

660 Ft. from N. Line Ft. from S. Line Ft. from E. Line990 Ft. from W. Line

SECTION PLAT

ZENITH POOL

Location Rig up

Drilling and Remarks:

*Vista 3772**5" @ 3783**3000 Acid**Born 22525-25-25**3000 Mat**42-6-25*

RECORD

Cased in., ft.Sand Gas Oil Total Depth 3808

PRODUCTION

1st 24 hrs. Nat. 1st 24 hrs. after shot Gas Cu. Ft.Dry Hole Abandoned

Date

SEP 24 1941

19

S. J. LEWIS Scout