

Stafford KANSAS


Form 51-5M-11-38-Palace

Section 18 Township 24 Range 13-W

Well No. 1 McConnaughbay

Company Lauck & Moncrief

NORTH Wildcat

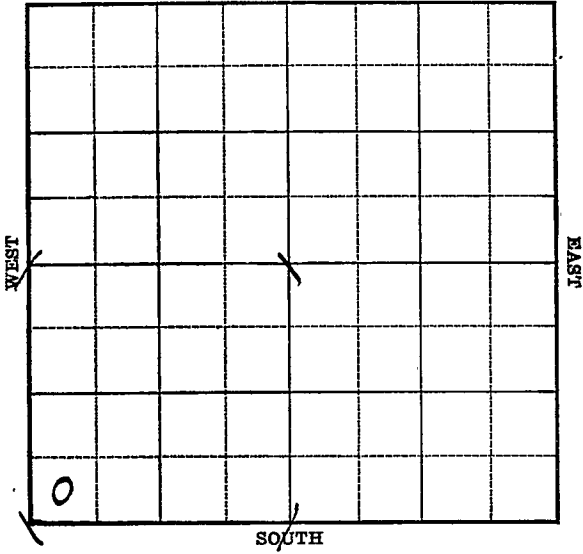

1939

5/10

Arb. 4211'

T.D. 4233'

P. B. 7" at 3900'

60 shots 3626-36'

1000 acid.

3000' water 12 hours.

ABANDONED

Map No. 83 Sec. 18 Twp. 24 R. 13W

Well No. 1 McConnaughbay

Lauck & Moncrief Company

Contractor

FIRST REPORT
SW/C


SECTION PLAT

_____ Ft. from N. Line

330 Ft. from S. Line

_____ Ft. from E. Line

350 Ft. from W. Line

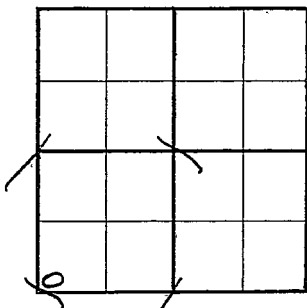

WILDCAT

Location X

Rig up _____

Drilling and Remarks:

RECORD

Cased _____ in., _____ ft.

Sand _____

Gas _____

Oil _____

Total Depth _____

PRODUCTION

1st 24 hrs. Nat. _____

1st 24 hrs. after shot _____

Gas _____ Gu. Ft.

Dry Hole _____

Abandoned _____

Date

MAR 8 - 1939 19 H. D. Hatfield Scout

Map No. 83 Sec. 18 Twp. 24 R. 13WWell No. 1 McConnaughayLauck & Moncrief Company

Contractor

ABANDONED
SW/C

_____ Ft. from N. Line

330 Ft. from S. Line

_____ Ft. from E. Line

330 Ft. from W. Line

WILDCAT

SECTION PLAT

Location _____

Rig up _____

Drilling and Remarks:

Cr 4211
P.B 7" C 8900
60 Shots 3626-36
1000 acid
3000' Water 12 hrs

RECORD

Cased _____ in., _____ ft.

Sand _____

Gas _____

Oil _____

Total Depth 4233

PRODUCTION

1st 24 hrs. Nat. _____

1st 24 hrs. after shot _____

Gas _____ Cu. Ft.

Dry Hole _____

Abandoned _____

Date

MAY 10 1939 19

S. J. LEWIS Scout