

Stafford

KANSAS

SECTION 18 TOWNSHIP 24 RANGE 14W

WELL NO. #1 Holderness

COMPANY SUNRAY MID-CONTINENT Oil Co.

NORTH

							0

WEST

EAST

SOUTH

HOT FILE Stafford KANSAS


SEC. 18 TWP. 24 S R. 14 W

WELL NO. # 1 Holderness Estate FARM
 COMPANY ~~Holderness-Estate-~~

CONTRACTOR Sunray Mid-Continent (EXPLORATORY)

Stickle Drlg.
SE Rattlesnake Area (Dillwyn Pool)

_____ Ft. from N. Line
 330 _____ Ft. from S. Line
 330 _____ Ft. from E. Line
 _____ Ft. from W. Line

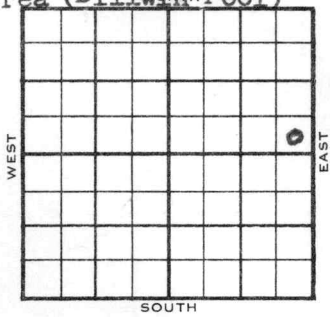

of NE/4
 SE SE NE

No Contract

1956 ELEVATION 1999' KB, 1996 DF REPORT (WH6-EX13)

4300' Arbuckle Test

5/1 Spudded 4-30-56
 8-5/8" @ 296' w/300
 TD 298' WOC (FR Tkt) (DR#85)

5/2 Drlg. 1330'

5/3 Drlg. 2090'

5/4 Drlg. 2515'

5/7 Drlg. 3535'

5/8 Drlg. 3778'

5/9 Drlg. 3900'

5/10 Drlg. 4023'

5/11 TD 4097'. DST 4080-4108'

5/14 Drlg. 4324'

5/15 TD 4335'. Plugged & Abandoned (DR#95)

5-16 DST 4080-4108 op 1 hr. gas in 40 min.,
 ga 139 MCF in 50 min., it.g. 62 MCF
 rec. 65' SGCM, FP 60-60, BHP 1440/20"
 DST 4110-22 op 1 hr. rec. 30' mud,
 FP 25-40, BHP 1305/20".
 DST 4145-62 op 1 hr, rec. 30' VSOCM,
 All press. 0.
 D & A
 Tops; H. 3564', BL. 3705', L. 3726',
 BKC 3975', Marm 4020', C. Sh. 4082',
 M. 4097', V. 4174', S.Sh. 4248'
 A. 4292'. Log tops: H. 3565', Dg. 3604
 BL. 3708', L. 3725', BKC 3994'.

1956

5-16 continued

C.Sh. 4066', M. 4099', K. 4152'.
V. 4179', S. Sh. 4245', S.Sd. 4269',
A. 4296'.
TD 4332'

ABANDONED

County Stafford Elev. _____
 Sec. 18 Twp. 24 Rge. 14W
 Company Sunray Mid-Continent
 Farm Name Holderness No. 1

TOPS	DEPTH	LOG	DATUM
Anh.			
Tp.			
H.			
Tr.			
Dg.			
Bl.			
L.			
K.C.			
B.K.C.			
Ce.			
C.			
M.			
M.			
K.			
Mz.			
Mq.			
V.			
S.			
S.			
A.			
R.			
Pe.			
G.			
T.D.			

Loc. in Sec. SE SE NE
 Geol. _____
 Contr. Stickle
 Pool Dillwin
 FIRST REPORT
 MAY 2 '56

Date Comm. 4-30-56
8" @ 296/300 WOC

13

County Stafford Elev. 1999 KB
1996 DF
 Sec. 18 Twp. 21 Rge. 11W
 Company Sunray Mid-Continent
 Farm Name Holderness No. 1

TOPS	DEPTH	LOG	DATUM	Loc. in Sec.
	3564	3565		SE SE NE
Sp				
Dg		3604		
BL	3705	3708		
L.	3726	3725		
K.C.				Geol.
B.K.C.	3975	3994		Contr.
Gen <u>Marm</u>	4020			Stickle
C. <u>sh</u>	4082	4066		
M.				Pool
M.	4097	4099		Dillwin
K.		4152?		
Mz.				
Me.				
V.	4174	4179		<div style="border: 1px dashed black; padding: 5px; display: inline-block;"> ABANDONED </div>
S. <u>sh</u>	4248	4245		
S. <u>sd</u>		4267		
A.	4292	4296		
R.				
PE.				
G.				
TD	4332			ABANDONED

Date Comm. 4-30-56 MAY 16 1956
8" @ 296/300 WOC MAY 9 '56 Hb 3564

BL 3705 L59 3726 ID 3790 MAY 15 '56
BKC 3975 Marm 4020 c9 sh 4082
MISS 4097 DST 4080-4108 op 1 hr
985 in 40" ga 139 MCF in 50" it ga
62 MCF rec. 65' SGCM FP 60-60 BHP
1440/20" DST 4110-22 op 1 hr rec
30' Md FP 25-40 BHP 1305/20"
Kd sd 4142 DST 4145-62 op 1 hr

Co. No. Sec. T. R.

rec 30' VSOCM All press 0 Viola
4174 sp 4248 Arb 4292 RTD
4332 Ran log H.C.A.