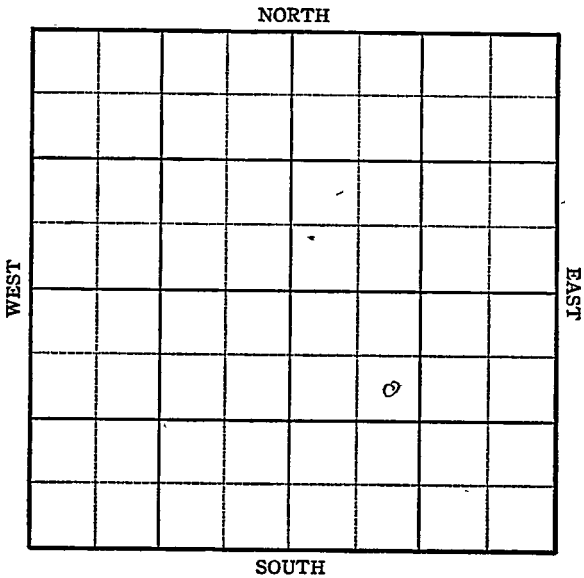


FORM 51 5M PETROL

Section 18 Township 24 Range 28WWell No. 1 BurbakerCompany E. Wakefield et al

KANSAS

Gray

Sec. 18 Twp. 24 R. 28-W


Well No. #1 Brubaker Farm
E. Wakefield et al Company

990 Ft. from N. Line

 Ft. from S. Line

 Ft. from E. Line

990 Ft. from W. Line

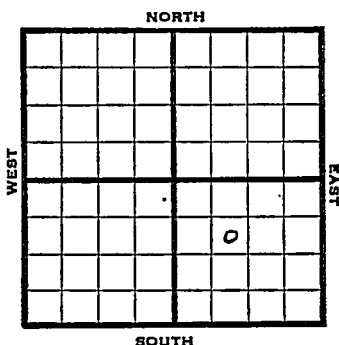

SE NW SE

1945 Elev. 2760

REPORT

11/14 RUR

11/21 "

11/28 Surface hole

12/5 13" @ 245
Drlg. 3100'

12/12 Drlg. 3487'

12/20 Dakota 400' Anhy 1870'
Lans 4099' Drlg. 4260'

12/29 Drlg. 4820'

1946

1/9 Lans 4130
Miss 4856
TD 4953'

ABANDONED

KANSAS

Pool Name HugotonMap No. 21 Map Sec. 18 Twp. 24 R. 28WWell No. 1 BrubakerE. Wakefield et al

Company

FIRST REPORT

Contractor

SE NW SE

SECTION PLAT

990 Ft. from N. Line Ft. from S. Line Ft. from E. Line990 Ft. from W. Line

Gray County

Location Rig up

Drilling and Remarks:

RUR

RECORD

Cased in., ft.Sand Gas Oil Total Depth

PRODUCTION

1st 24 hrs. Nat. 1st 24 hrs. after shot Gas Cu. Ft.Dry Hole Abandoned

Date

NOV 14 1945 19

S. J. LEWIS

Scout


KANSAS

Kansas Pool Name HugotonMap No. 18 Sec. 24 Twp. 28WWell No. 1 BrubakerE. Wakefield et al Company

ABANDONED

Contractor

SE NW SE

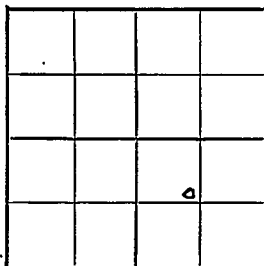E 1,2760
SECTION PLAT990 Ft. from N. Line Ft. from S. Line Ft. from E. Line990 Ft. from W. Line

Gray County

Location Rig up

Drilling and Remarks:

Lease 4/80
Miss 4866

RECORD

Cased in., ft.Sand Gas Oil Total Depth 4253

PRODUCTION

1st 24 hrs. Nat. 1st 24 hrs. after shot Gas Cu. Ft.Dry Hole Abandoned

Date

JAN 9 1946 19 S. J. LEWIS Scout