


KANSAS^{Finney}

Section 18 Township 24 Range 34-WWell No. #1 McGoingal (McGonigal)Company Champlin Ref.Hugoton Pool

NORTH

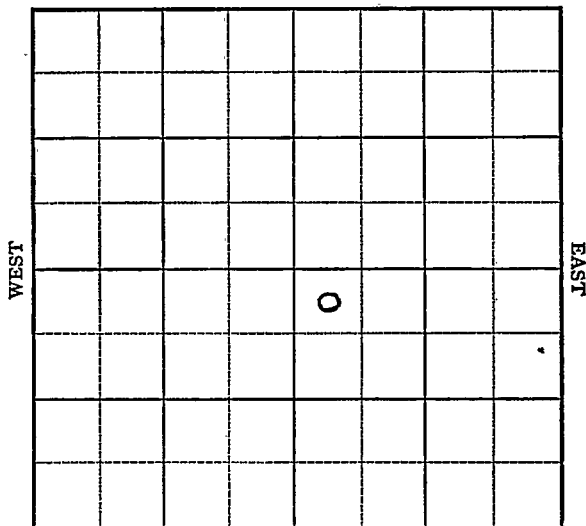

SOUTH

KANSAS


Finney ✓

Sec. 18 Twp. 24 R. 34WWell No. 1 McGoingal FarmChamplin Ref. Company

Hugoton Pool

330 Ft. from N. Line Ft. from S. Line Ft. from E. Line330 Ft. from W. Line

NW SE

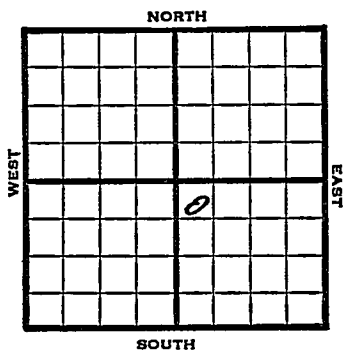

1949

Elev 2933'

REPORT

8/24

Location

8/31

"

9/7

"

9/14

"

9/21

"

9/28

"

10/5

"

10/12

"

10/19

"

10/26

"

11/1

"

11/9

"

11/16

"

11/23

RUR

11/29

"

12/7

9" @ 668'

TD 2590'

7" @ 2590'

12/14

"

12/21

"

12/28

"

1950

3/8

TD 2590'

9" @ 668'

7" @ 2590'

Her 2403'

Gr 2435'

Win 2503'

18,000,000 CFGPD

COMPLETED
horry

Kansas

Hugoton Pool

Map No. _____ Sec. 18 Twp. 24 R. 34WWell No. 1 McGoingal

Champlin Ref.

Company _____

Contractor _____

NW SE

FIRST REPORT
SECTION PLAT330 Ft. from N. Line

_____ Ft. from S. Line

_____ Ft. from E. Line

330 Ft. from W. Line

		D	

Finney County

Location X

Rig up _____

Drilling and Remarks:

RECORD

Cased _____ in., _____ ft.

Sand _____

Gas _____

Oil _____

Total Depth _____

PRODUCTION

1st 24 hrs. Nat. _____

1st 24 hrs. after shot _____

Gas _____ Cu. Ft.

Dry Hole _____

Abandoned _____

Date

AUG 24 1949

19

S. J. LEWIS Scout

~~Kansas~~

Hugpton Pool

Map No. _____ Sec. 18 Twp. 24 R. 34WWell No. 1 McGoingal

Champlin Ref. _____ Company _____


Contractor _____

NW SE

E1. 2933
SECTION PLAT330 Ft. from N. Line

_____ Ft. from S. Line

_____ Ft. from E. Line

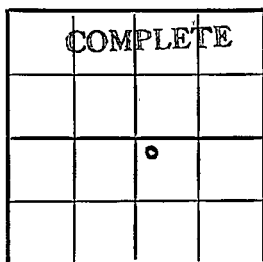330 Ft. from W. Line

Finney County

Location _____

Rig up _____

Drilling and Remarks:

9" @ 6687" @ 2590Nov 2403Cr. 2435Win 250318,000,000CFGPD

Date

MAR 8 1950

RECORD

Cased _____ in., _____ ft.

Sand _____

Gas _____

Oil _____

Total Depth 2590

PRODUCTION

1st 24 hrs. Nat. _____

1st 24 hrs. after shot _____

Gas _____ Cu. Ft.

Dry Hole _____

Abandoned _____

J. E. TYRA

19

Scout