


Section 19 Township 24 Range 4-W

Well Number 4 Hogan

Company Carter

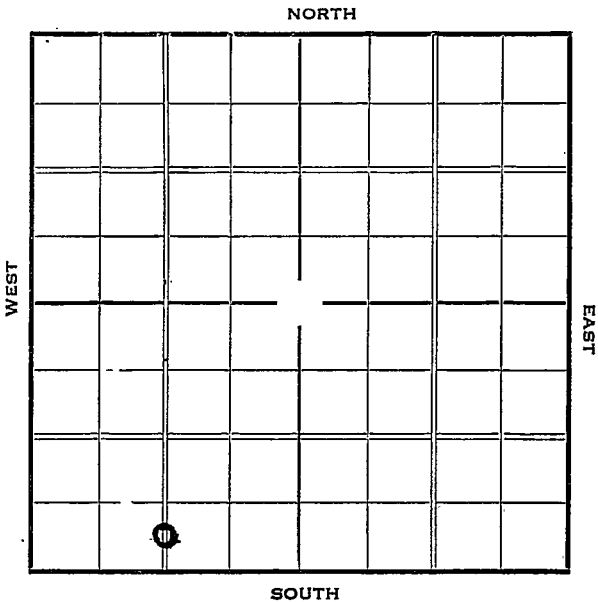

1937

6/16 7" @ 3336'.

Chat 3329'.

T.D. 3389'.

1000 acid @ 3380'.

2000 acid @ 3380'.

T.D. 3389'. 1500 acid.

Pot. 365 oil, 59 water.

COMPLETED

Reno

Map No. _____ Sec. 19 Twp. 24 R. 4WWell No. 4 HoganCarter Company

Contractor

SECTION PLAT

_____ Ft. from N. Line

330 Ft. from S. Line1320 Ft. from E. Line

_____ Ft. from W. Line

FIRST REPORT

Location ✓

Rig up _____

Drilling and Remarks:

RECORD

Cased _____ in., _____ ft.

Sand _____

Gas _____

Oil _____

Total Depth _____

PRODUCTION

1st 24 hrs. Nat. _____

1st 24 hrs. after shot _____

Gas _____ Cu. Ft.

Dry Hole _____

Abandoned _____

Date

APR 7 1937 19

S. J. LEWIS

Scout

KANSAS

Map No. 40 Sec. 19 Twp. 24 R. 4 WWell No. 4-HoganCarter Company

Contractor

COMPLETED

SECTION PLAT

_____ Ft. from N. Line

330 Ft. from S. Line1320 Ft. from E. Line1500 Ft. from W. Line

Location _____

Rig up _____

Drilling and Remarks: 1000 Acid @ 33802000 ✓T.D. 3389-1500 AcidPost 36501159 water

RECORD

Cased 7 in., 3336 ft.Sand CHAT 3329

Gas _____

Oil _____

Total Depth 3389

PRODUCTION

1st 24 hrs. Nat. _____

1st 24 hrs. after shot _____

Gas _____ Cu. Ft.

Dry Hole _____

Abandoned _____

Date

JUN 16 1937 19

H. D. Hatfield

Scout