


Section 19 Township 24 Range 4-W


Well Number 5 - Hogan

Company Carter

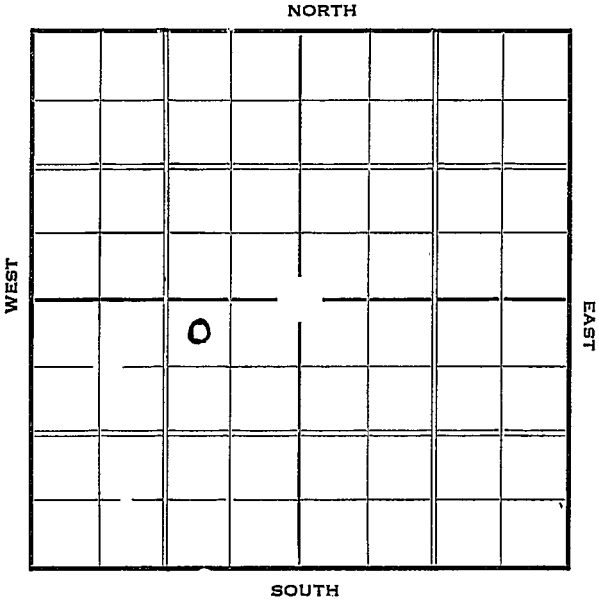

Sec. 19 Twp. 24 R. 4-WWell No. 5 - Hogan FarmCarter Company330 Ft. from N. Line Ft. from S. Line990 Ft. from E. Line Ft. from W. Line

Elev. 1473

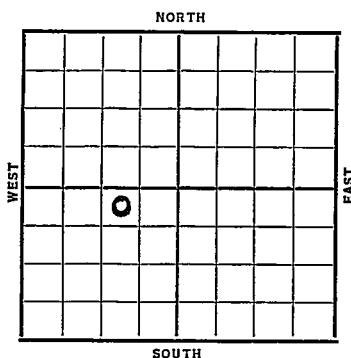

Date	REPORT
1937	
4/28	Location
5/7	Rig
5/14	10" @ 547'. Drlg. 560'.
5/21	Fsg. 2131'.
5/28	15" @ 808'. Drlg. 2440'.
6/4	Drlg. 2954'.
6/11	Chat 3338'. T.D. 3348'.
	5" @ 3346'. RUST.
6/19	" " "
6/25	T.D. 3390'. 1500 acid.
6/30	5" @ 3346'.
	Chat 3338'.
	T.D. 3390'.
	1500 A.
	Pot. 404 bbls.
	COMPLETED

Reno **KANSAS**Map No. _____ Sec. 19 Twp. 24 R. 4 ^WWell No. 5 - HoganCarter Company

Contractor

FIRST REPORT**SECTION PLAT**

	0		

330 Ft. from N. Line

_____ Ft. from S. Line

990 Ft. from E. Line

_____ Ft. from W. Line

Location ✓

Rig up _____

Drilling and Remarks:

RECORD

Cased _____ in., _____ ft.

Sand _____

Gas _____

Oil _____

Total Depth _____

PRODUCTION

1st 24 hrs. Nat. _____

1st 24 hrs. after shot _____

Gas _____ Cu. Ft.

Dry Hole _____

Abandoned _____

Date

APR 28 1937

19

H. D. Hatfield Scout

Reservoir **KANSAS**Map No. _____ Sec. 19 Twp. 24 R. 4^wWell No. 5- HoganCarter Company

Contractor _____

COMPLETED**SECTION PLAT**

	0		

530 Ft. from N. Line

_____ Ft. from S. Line

990 Ft. from E. Line

_____ Ft. from W. Line

Location _____

Rig up _____

Drilling and Remarks:

1500 A,Pat- 404**RECORD**Cased 5 in. 3346 ft.Sand chat 3338

Gas _____

Oil _____

Total Depth 3390**PRODUCTION**

1st 24 hrs. Nat. _____

1st 24 hrs. after shot _____

Gas _____ Cu. Ft.

Dry Hole _____

Abandoned _____

Date

JUN 30 1937 19E. D. Hatfield

Scout