


Section 19 Township 24 Range 4-W


Well Number 6 Hogan

Company Carter

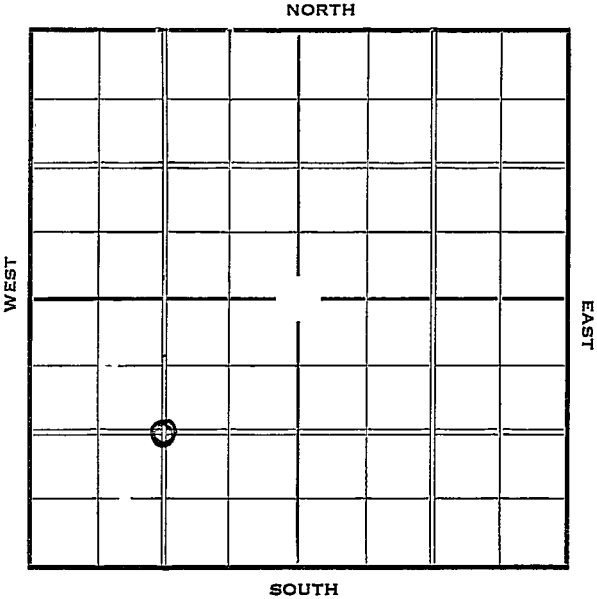

Sec. 19 Twp. 24 R. 4-WWell No. #6 Hogan Farm
Carter Company Ft. from N. Line1320 Ft. from S. Line Ft. from E. Line1320 Ft. from W. Line

Elev. 1477

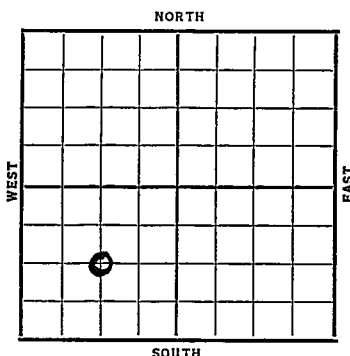

Date	REPORT
1937	
5/5	B. R. R.
5/14	R. R.
5/21	10" @ 551'.
5/28	Drlg. 2353'.
6/4	Drlg. 2834'.
6/11	Chat 3320'. T.D. 3331'.
	7" @ 3327'. RUST.
6/19	" " " "
6/25	" " " "
7/2	T.D. 3390'. Swab 95 bbls. 7 hours.
7/7	7" @ 3327'.
	Chat 3320'.
	T.D. 3390'.
	1500 A.
	Pot. 257 oil & 57 Water.
	COMPLETED

KANSAS

Map No. 46 Sec. 19 Twp. 24 R. 4 WWell No. 6 - HoganCarter Company

Contractor

FIRST REPORT

 Ft. from N. Line1320 Ft. from S. Line Ft. from E. Line1320 Ft. from W. Line

SECTION PLAT

Location Rig up

Drilling and Remarks:

B. R. R.

RECORD

Cased in., ft.Sand Gas Oil Total Depth

PRODUCTION

1st 24 hrs. Nat. 1st 24 hrs. after shot Gas Cu. Ft.Dry Hole Abandoned

Date

MAY 5 - 1937

19

H. D. Hatfield Scout

Reno KANSAS

Map No. 40 Sec. 19 Twp. 24 R. 4^WWell No. 6-HoganCarter Company

Contractor

COMPLETED

_____ Ft. from N. Line

1320 Ft. from S. Line

_____ Ft. from E. Line

1320 Ft. from W. Line

SECTION PLAT

Location _____

Rig up _____

Drilling and Remarks:

1500 A.fat 257 oil
57 wat

RECORD

Cased 7 in. 3327 ft.Sand Chat 3320

Gas _____

Oil _____

Total Depth 3390

PRODUCTION

1st 24 hrs. Nat. _____

1st 24 hrs. after shot _____

Gas _____ Cu. Ft.

Dry Hole _____

Abandoned _____

Date

JUL 7 1937 19H. D. Hatfield

Scout