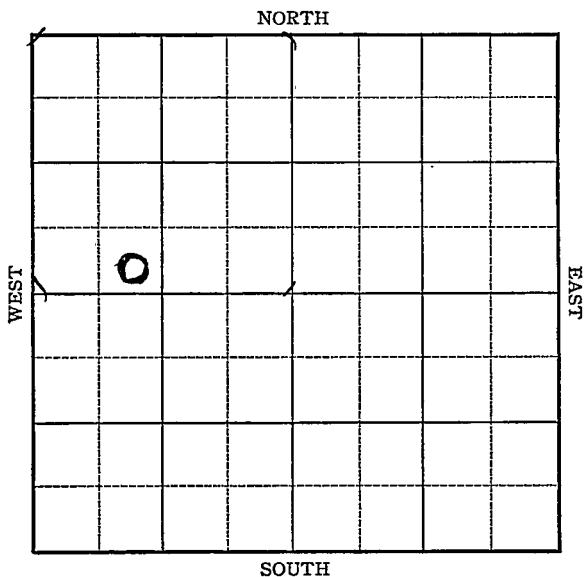


Section 19 Township 24 Range 4-WWell No. 1 - MuellerCompany Stanolind

Sec. 19 Twp. 24 R. 4-W

Well No. #1-Mueller Farm

Stanolind Company


_____ Ft. from N. Line

330 Ft. from S. Line

Ft. from E. Line

990 Ft. from W. Line

Elev. 1472'

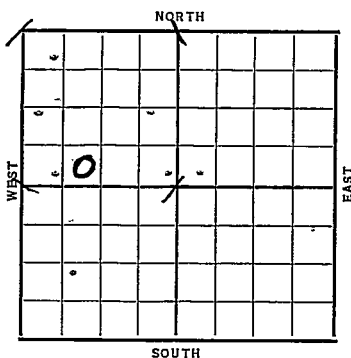

Date	REPORT
1937	
8/4	Location
8/13	Rig.
8/20	T.D. 498'. Rng. 13".
8/28	13" @ 476'. Drlg. 1335'.
9/3	Drlg. 2840'.
9/10	Miss. 3336'. 6" @ 3338'.
	T.D. 3340'. RUST. No shows rep.
9/17	T.D. 3375'. 1200' oil W/S.W.
9/24	Run tubing.
10/2	1000 acid. Pumped 39 oil & 98 water. Drlg. 3380'.
10/8	Inc. in oil 3389-90'.
	Swab 16 B.O.P.H. 1000 acid.
	OVER

1937

10/13 8" @ 3338'.

Miss. 3336'.

T.D. 3390'.

1000 acid.


1000 acid.

Potential 401 bbls. oil & 120 water.

COMPLETED

Reno **KANSAS**Map No. 40 Sec. 19 Twp. 24 R. 4wWell No. 1-MuellerStanolind Company

Contractor

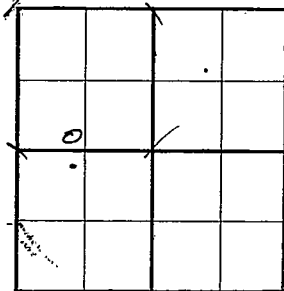FIRST REPORT**SECTION PLAT**

_____ Ft. from N. Line

330 Ft. from S. Line

_____ Ft. from E. Line

990 Ft. from W. Line

Location _____

Rig up _____

Drilling and Remarks:

RECORD

Cased _____ in., _____ ft.

Sand _____

Gas _____

Oil _____

Total Depth _____

PRODUCTION

1st 24 hrs. Nat. _____

1st 24 hrs. after shot _____

Gas _____ Cu. Ft.

Dry Hole _____

Abandoned _____

Date

AUG 4 - 1937 19H. D. Hatfield

Scout

Reno **KANSAS**Map No. 40 Sec. 19 Twp. 24 R. 4WWell No. 1 MuellerStanolind

Company

Contractor

COMPLETED

SE SW NW

Ft. from N. Line

330 Ft. from S. Line

Ft. from E. Line

990 Ft. from W. Line**SECTION PLAT**

0			

Location _____

Rig up _____

Drilling and Remarks:

1000 Acid1000 ✓POT - 401 oil
120 water**RECORD**Cased 8 in., 3338 ft.Sand MISS 3336

Gas _____

Oil _____

Total Depth 3390**PRODUCTION**

1st 24 hrs. Nat. _____

1st 24 hrs. after shot _____

Gas _____ Cu. Ft.

Dry Hole _____

Abandoned _____

Date

OCT 13 1937 19H. D. Hatfield Scout