
Form 51-5M-12-36 Com'l

Reno KANSAS

Section 19 Township 24 Range 4-W

Well Number 3 Tucker

Company National Refg.

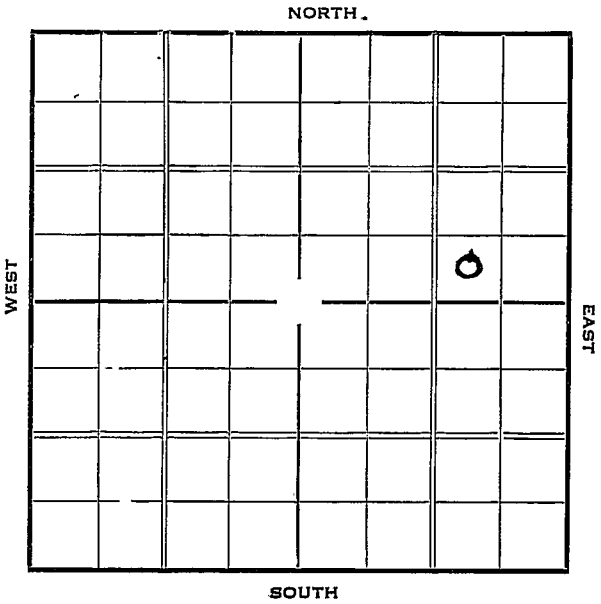


Form 252-A—5M—2-37—Palace KANSAS Reno

Sec. 19 Twp. 24 R. 4-W

Well No. #3 Tucker Farm

National Ref. Company

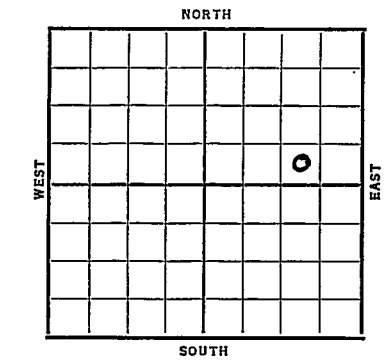

Ft. from N. Line

330 Ft. from S. Line

990 Ft. from E. Line

Ft. from W. Line

Elev. 1469

Date	REPORT
1937	
4/7	Rig
4/16	Rigging up.
4/23	12" @ 490'. WOC.
4/30	Drlg. 1980'.
5/7	Drlg. 2925'.
5/14	Chat 3324'. 7" @ 3326'. WOC.
5/21	Flowed 10 bbls. per hour.
5/26	7" @ 3326'.
	Chat 3324'.
	T.D. 3391'.
	3000 acid.
	Pot. 1754 bbls. flow.
	COMPLETED

Form 26—1M Bks.—2-24 KANSAS Rev.


Map No. 40 Sec. 19 Twp. 24 R. 4W

Well No. 3 Tucker

National Ref. Company

Contractor

SECTION PLAT

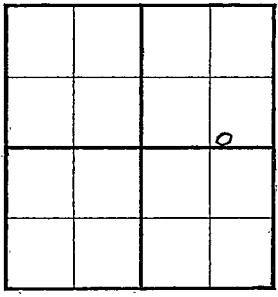

_____ Ft. from N. Line

330 Ft. from S. Line

990 Ft. from E. Line

_____ Ft. from W. Line

FIRST REPORT

Location_____

Rig up_____

Drilling and Remarks:

Rig

RECORD

Cased_____ in., _____ ft.

Sand_____

Gas_____

Oil_____

Total Depth_____

PRODUCTION

1st 24 hrs. Nat._____

1st 24 hrs. after shot_____

Gas_____ Cu. Ft.

Dry Hole_____

Abandoned_____

Date

APR 7 1937 19_____ S. J. LEWIS Scout

Form 26—1M Bks.—2-29 Reno KANSAS

Map No. 40 Sec. 19 Twp. 24 R. 4 W

Well No. 3 - Tucker

National Pet Company

Contractor

COMPLETED


Ft. from N. Line

330 Ft. from S. Line

990 Ft. from E. Line

Ft. from W. Line

SECTION PLAT

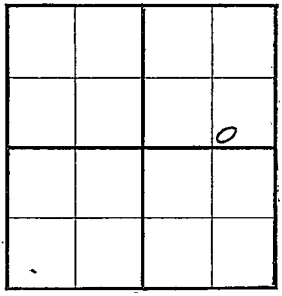

Location

Rig up

Drilling and Remarks:

3000 Acid

Pat - 1754

Flow

RECORD

Cased 7 in., 3326 ft.

~~Sand~~ Chat 3324

Gas

Oil

Total Depth 3391

PRODUCTION

1st 24 hrs. Nat.

1st 24 hrs. after shot.

Gas Cu. Ft.

Dry Hole

Abandoned

Date

MAY 26 1937 19

H. D. Hatfield Scout