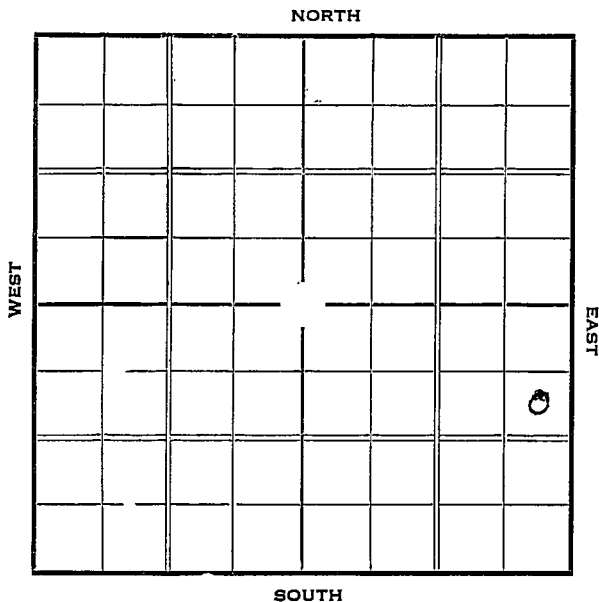


Section 19 Township 24 Range 4-W

#2 "B"

Well Number ~~8~~ WestfallCompany Barnsdall

KANSASMap No. 40 Sec. 19 Twp. 24 R. 4WWell No. 3 WestfallBarnsdall Company

Contractor

SECTION PLAT

			o

990 Ft. from N. Line

_____ Ft. from S. Line

330 Ft. from E. Line

_____ Ft. from W. Line

FIRST REPORT**RECORD**Location ✓

Cased _____ in., _____ ft.

Rig up _____

Sand _____

Drilling and Remarks:

Gas _____

Oil _____

Total Depth _____

PRODUCTION

1st 24 hrs. Nat. _____

1st 24 hrs. after shot _____

Gas _____ Cu. Ft.

Dry Hole _____

Abandoned _____

Date

FEB 17 1937

19

S. J. LEWIS Scout

KANSAS

Map No. _____ Sec. 19 Twp. 24 R. 4W

Well No. 2 "B" Vestfall

Barnes & Co Company

Contractor

SECTION PLAT

			0

990 Ft. from N. Line

_____ Ft. from S. Line

330 Ft. from E. Line

_____ Ft. from W. Line

CORRECTION

Location _____

Rig up _____

Drilling and Remarks:

*Reported as
No 32 Vestfall*

RECORD

Cased _____ in., _____ ft.

Sand _____

Gas _____

Oil _____

Total Depth _____

PRODUCTION

1st 24 hrs. Nat. _____

1st 24 hrs. after shot _____

Gas _____ Cu. Ft.

Dry Hole _____

Abandoned _____

Date

FEB 24 1937 ₁₉

S. J. LEWIS Scout

KANSAS*Renov.*Map No. _____ Sec. 19 Twp. 24 R. 4WWell No. 2. Westfall "B"Barnes & Co. Company

Contractor

SECTION PLAT

			0

990 Ft. from N. Line Ft. from S. Line330 Ft. from E. Line Ft. from W. Line**COMPLETED**

Location _____

Rig up _____

Drilling and Remarks:

*Chaf 3336.**Potential 1575**cut 8%**natural***RECORD**

Cased _____ in., _____ ft.

Sand _____

Gas _____

Oil _____

Total Depth 3385**PRODUCTION**

1st 24 hrs. Nat. _____

1st 24 hrs. after shot _____

Gas _____ Cu. Ft.

Dry Hole _____

Abandoned _____

Date

APR 7 1937

19

S. J. LEWIS

Scout