


Section 19 Township 24 Range 7W

Well No. 1 Linshied

Company Geo. Siegrist et al  
Abbey

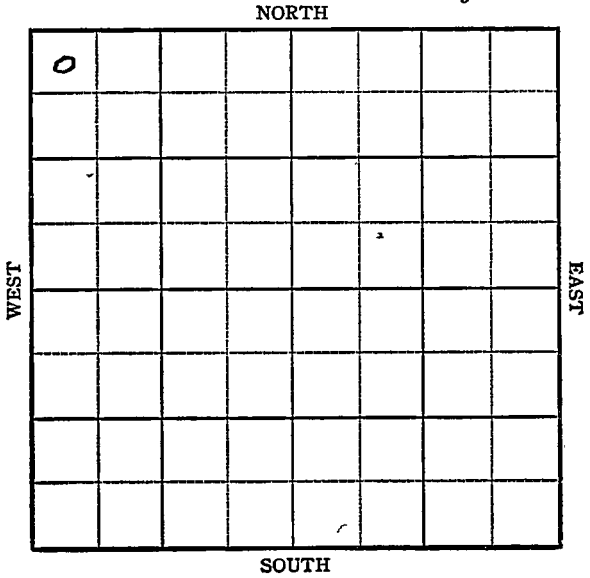

KANSAS

Reno

Sec. 19 Twp. 24 R. 7W ✓

Well No. #1 Linshied Farm

Geo. Siegrist et al Company

Abbey Pool


330' Ft. from N. Line

\_\_\_\_\_ Ft. from S. Line

\_\_\_\_\_ Ft. from E. Line

330' Ft. from W. Line

NW/C

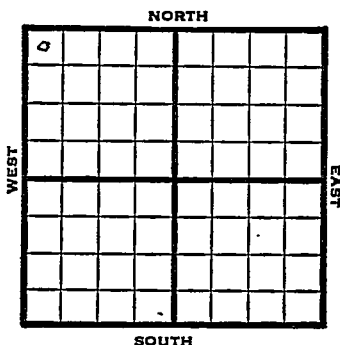

1949 Elev 1631' REPORT

1/19 RUR  
 1/26 8" @ 197'  
 Drlg 1740'  
 2/2 Drlg 2675'  
 2/9 TD 3524  
 5" @ 3522'  
 2/16 "  
 2/23 Lansing 3187'  
 TD 3524'  
 Swb bbls oil PH - 20 hrs.  
 3/2 "  
 3/9 TD 3524'  
 Lans. 3387'  
 5" @ 3522'  
 Pump 50 oil Pot  
 38° gr.  
 Comp

**COMPLETED**

Map No. \_\_\_\_\_ Sec. 19 Twp. 24 R. 7W

Well No. 1 Linshied

Geo. Siegrist etal. Company

FIRST REPORT Contractor

NW/C

SECTION PLAT

330 Ft. from N. Line

\_\_\_\_\_ Ft. from S. Line

\_\_\_\_\_ Ft. from E. Line

330 Ft. from W. Line

0			

Reno County

RECORD

Location \_\_\_\_\_

Cased \_\_\_\_\_ in., \_\_\_\_\_ ft.

Rig up \_\_\_\_\_

Sand \_\_\_\_\_

Drilling and Remarks:

Gas \_\_\_\_\_

Oil \_\_\_\_\_

Total Depth \_\_\_\_\_

R U R

PRODUCTION

1st 24 hrs. Nat. \_\_\_\_\_

1st 24 hrs. after shot \_\_\_\_\_

Gas \_\_\_\_\_ Cu. Ft.

Dry Hole \_\_\_\_\_

Abandoned \_\_\_\_\_

Date

JAN 19 1949 19

S. J. LEWIS Scout

Map No. 41 Sec. 19 Twp. 24 R. 7W

Well No. 1 Linshied

Geo. Siegrist et al. Company

COMPLETE

Contractor

NW/C

*E 11631*  
SECTION PLAT

330 Ft. from N. Line

\_\_\_\_\_ Ft. from S. Line

\_\_\_\_\_ Ft. from E. Line

330 Ft. from W. Line

0			

Reno County

Location \_\_\_\_\_

Rig up \_\_\_\_\_

Drilling and Remarks:

*Lease 3387*

*5" @ 3522.*

*Pump 50 oil bot*

*35° SW*

RECORD

Cased \_\_\_\_\_ in., \_\_\_\_\_ ft.

Sand \_\_\_\_\_

Gas \_\_\_\_\_

Oil \_\_\_\_\_

Total Depth 3524

PRODUCTION

1st 24 hrs. Nat. \_\_\_\_\_

1st 24 hrs. after shot \_\_\_\_\_

Gas \_\_\_\_\_ Cu. Ft.

Dry-Hole \_\_\_\_\_

Abandoned \_\_\_\_\_

Date

MAR 9 1949 19

S. J. LEWIS Scout