


Section 19 Township 24 Range 7WWell No. #2 Linscheid "A"Company D B & Q Oil

NORTH

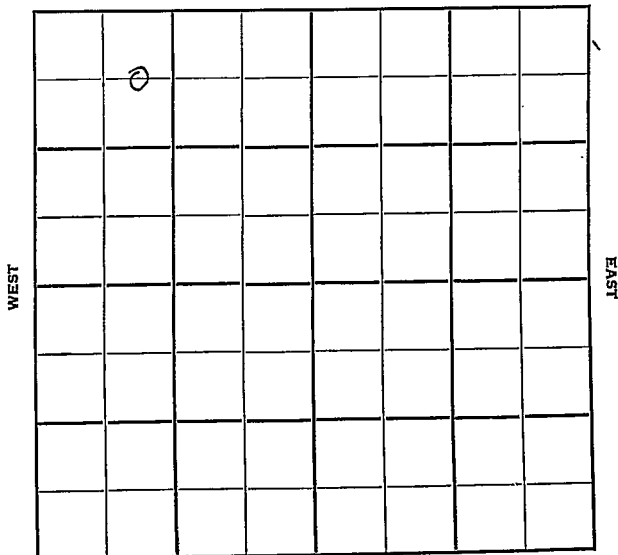

SOUTH

Reno

KANSAS

Sec. 19 Twp. 24 R. 7W

Well No. #2 Linscheid "A" Farm

D.B. & Oil. Company

Sterling Drlg. Contractor

Abbeyville


660' Ft. from N. Line

 Ft. from S. Line

 Ft. from E. Line

990' Ft. from W. Line

C E L NW NW

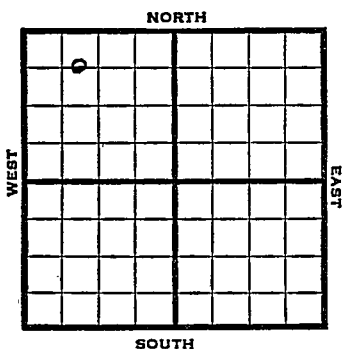

1950 Elev. 1632' REPORT

5/3 Spud 4-30-50
8" @ 180'

5/31 Drlg. 1300'

8" @ 180

Lans 3181

Pay 3514

5" @ 3516

TD 3526

PB 3521

5 qt 3516-21

1000A

FU 1600' oil in 12 hr

comp 20 bopd

COMPLETED

Kansas

Abbeyville Pool

Map No. _____ Sec. 19 Twp. 24 R. 7W

Well No. 2 Linscheid "A"

D B & Q Oil _____ Company

Sterling Drlg. _____ Contractor

C E L NW NW


E/ 632
SECTION PLAT

660 Ft. from N. Line

_____ Ft. from S. Line

_____ Ft. from E. Line

990 Ft. from W. Line

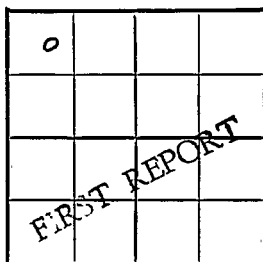

Reno County

Location _____

Rig up _____

Drilling and Remarks:

Spud 4-30-50

8" C 180

drlg. 1300

RECORD

Cased _____ in., _____ ft.

Sand _____

Gas _____

Oil _____

Total Depth _____

PRODUCTION

1st 24 hrs. Nat. _____

1st 24 hrs. after shot _____

Gas _____ Cu. Ft.

Dry Hole _____

Abandoned _____

Date

MAY 3 1950 19

J. E. TYRA

Scout

Map No. _____ Sec. 19 Twp. 24 R. 7WWell No. 2 Linscheid "A"D B & Q Oil CompanyC E L NW NW ContractorE1.1632
SECTION FLAT660 Ft. from N. Line

_____ Ft. from S. Line

_____ Ft. from E. Line

990 Ft. from W. Line

0			

COMPLETE

Reno _____

Location _____

Rig up _____

Drilling and Remarks:

8" C 180

Lans. 3181

Pay 3514

5" C 3516

T.D. 3526

PB 3521

524. 3516-21

1000 A

Date

RECORD

Cased _____ in., _____ ft.

Sand _____

Gas _____

Oil _____

Total Depth 3526**PRODUCTION**

1st 24 hrs. Nat. _____

1st 24 hrs. after shot _____

Gas _____ Cu. Ft.

Dry Hole _____

Abandoned _____

OVERJ. E. TYRA Scout

MAY 31 1950

19

74. 1600⁰ oil in 12 hr.

Comp. 20 load

Scout Cards
Land Small Map
Land Wall Map
Tracings
France Map
Pierce Map
Misc.

1956 9

June

1956 9 10








 






