


Section 19 Township 24 Range 7 W

Well No. 2 - (B) Lincheid

Company D. B. & Q. Oil

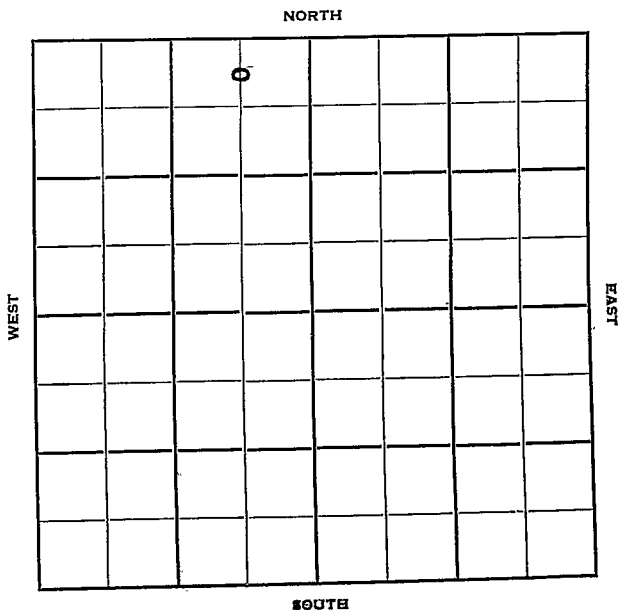

Reno

KANSAS

Sec. 19 Twp. 24 R. 7W ✓

Well No. #2 (B) Lincheid Farm

D. B. & Q. Oil Company

Sterling Contractor

Abbyville


330' Ft. from N. Line

Ft. from S. Line

660' Ft. from E. Line

Ft. from W. Line

N/2 NE NW

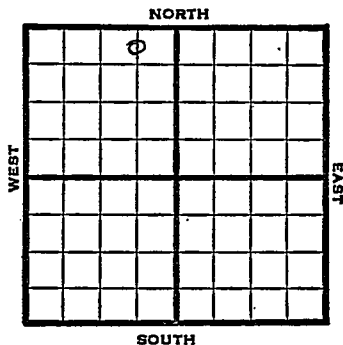

1950 Elev. 1632' REPORT

5/17 Spud 5-11-50
8" @ 180'
Drlg. 1770'

6/7 8" @ 180'
Lans. 3160'
5" @ 3509'
75 BOPD
TD 3515'

COMPLETED

Map No. _____ Sec. 19 Twp. 24 R. 7WWell No. 2-(B) LincheidD. B. & O. Oil CompanySterling ContractorN/2 NE NW

SECTION PLAT

330 Ft. from N. Line

_____ Ft. from S. Line

660 Ft. from E. Line

_____ Ft. from W. Line

	0		
FIRST	REPORT		

Reno

Location _____

Rig up _____

Drilling and Remarks:

Spud 5-11-50

8" @ 180

Drlg. 1770

RECORD

Cased _____ in., _____ ft.

Sand _____

Gas _____

Oil _____

Total Depth _____

PRODUCTION

1st 24 hrs. Nat. _____

1st 24 hrs. after shot _____

Gas _____ Cu. Ft.

Dry Hole _____

Abandoned _____

Date

MAY 17 1950 19J. E. TYRA Scout

Kansas

Map No. _____ Sec. 19 _____ Twp. 24 _____ R. 7W

Well No. 2 (B) Lincheid

D. B. & Q. Oil _____ Company

N/2 NE NW _____ Contractor


E1.1632
SECTION PLAT

330 _____ Ft. from N. Line

_____ Ft. from S. Line

660 _____ Ft. from E. Line

_____ Ft. from W. Line

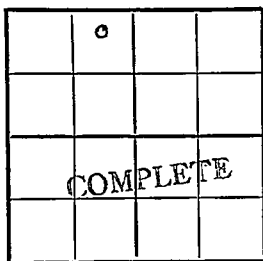

Reno

Location _____

Rig up _____

Drilling and Remarks:

9" @ 180
 Lens 3160
 5" @ 3509
 75 BOPD

RECORD

Cased _____ in., _____ ft.

Sand _____

Gas _____

Oil _____

Total Depth 3515

PRODUCTION

1st 24 hrs. Nat. _____

1st 24 hrs. after shot _____

Gas _____ Cu. Ft.

Dry Hole _____

Abandoned _____

Date

JUN 7 1950

19

J. E. TYRA Scout