


Section 19 Township 24 Range 7WWell No. #2 WesleyCompany Geo. Siegrist et al

NORTH

add. Loc.

WEST

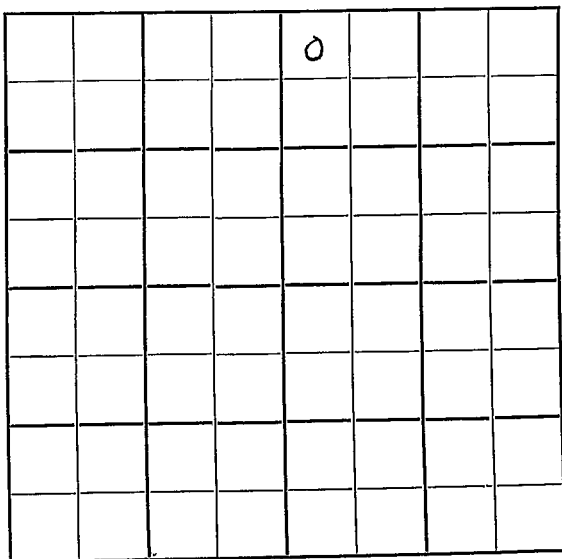

SOUTH

EAST

KANSAS

Reno

Sec. 19 Twp. 24 R. 7W ✓

Well No. #2 Wesley Farm

Geo Siegrist et al Company

Contractor

Abbeyville Pool


330' Ft. from N. Line

Ft. from S. Line

Ft. from E. Line

330' Ft. from W. Line

NW NW NE

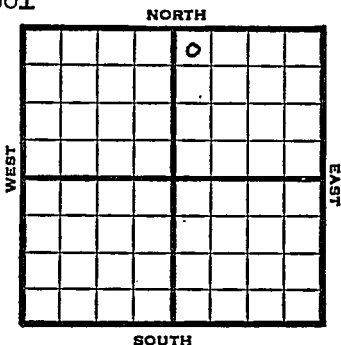

1950

?

REPORT

10/4

Location

12/20

Location Abandoned

ABANDONED

County Reno State KansasSec. 19 (Blk. Twp.) 24 (Sur. Rge.) 7W Map No.Operator Geo. Siegrist et al.Well No. 2 Farm Hess WesleyElev. Location NW NW NE

				0			

330 Ft. From N Line NE330 Ft. From W Line Quarter1st. Report OCT 4 1950

Completion

Remarks

Spudding Date

Drig. Data Abbeyville Pool

Location



Operator Geo. Siegrist et al.

Well No. 2 Farm Hess - (21.0.0.0.0)

Elev.	Location	NW	NW	NE
-------	----------	----	----	----

330 Ft. From N Line NE

330 Ft. From W Line Quarter

1st. Report

Completion DEC 20 1950

Remarks _____

Spudding Date _____

Drlg. Data _____

Location abd.