


DX 78-1

Section 19 Township 24 Range 11W

Well No. #1 Allen

Company Harms-Burt Drlg. et al

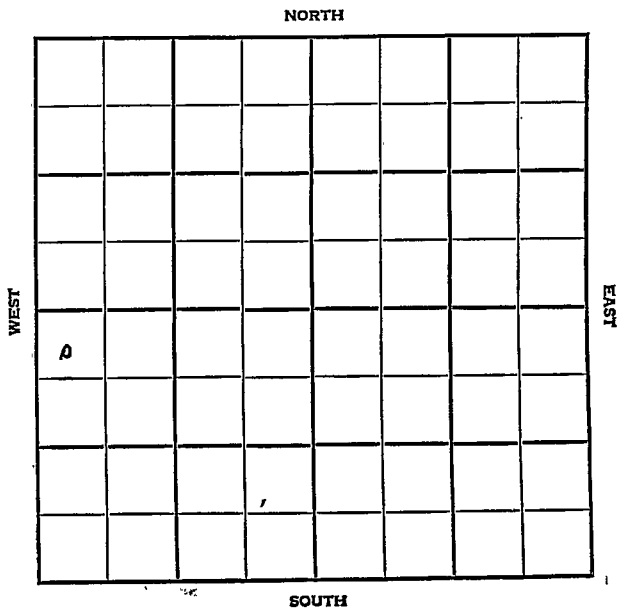

SEC.	19	TWP.	24	R.	11W
------	----	------	----	----	-----

WELL NO.

#1 Allen

FARM

COMPANY

Harms-Burt Drlg. et al

CONTRACTOR

Co. Tools.

Wildcat.

330

Ft. from N. Line


Ft. from S. Line

Ft. from E. Line

330

Ft. from W. Line

NW NW SW

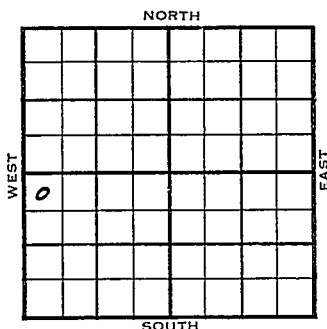

1954	ELEVATION	REPORT
	1840'	

11/23 Location

12/15 Spud 11-29-54 D & A TD 4109
 8" @ 210 Heeb 3287 Br. lime 3442
 Lans. 3472
 DST 3668-93 open 1 hr rec 45' wtry
 mud. 1350# B KC 3755 Kh. 3801
 Viola 3906 Simp. sh. 4013
 Simp. sd 4032 Arb. 4071 TD 4109
 Schl tops: Heeb 3287 Br lime 3442
 Lans 3471 Cong. 3803 Kh. 3812
 Maq. 3859 Viola 3903 Simp sh. 4014
 Simp sd 4032 Arb. 4068
 D & A

ABANDONED

County **Stafford** State **Kansas**

Sec. 19 (Blk. Twp.) 24 (Sur. Rge.) 11W Map No.

Operator **Harms-Burt Drlg. etal.**

Well No. 1 Farm Allen

Elev.	Location	NW	NE	SW	SE
-------	----------	----	----	----	----

[illegible]

330 Ft. From N Line SW

330 Ft. From W Line Quarter

1st. Report NOV 23 1954

Completion

Remarks

Co. tools


Spudding Date _____

Drlg. Data Wildcat

Location

FABEN GILSTRAP

County Stafford State Kansas
 Sec. 19 (Blk. 24 (Sur. 11W Map No.
 (Twp.) (Rge.)
 Operator Harms-Burt Drlg. etal.
 Well No. 1 Farm Allen
 Elev. 1840 Location NW NW SW

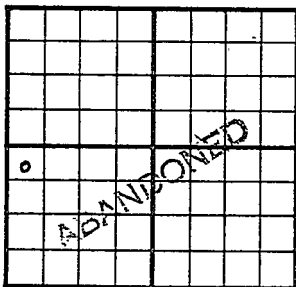

330 Ft. From N Line SW
330 Ft. From W Line Quarter
 1st. Report
 Completion DEC 15 1954
 Remarks Wildcat
Co. tools
 Spudding Date 11-29-54

Drlg. Data D & A TD 4109

8" @ 210 Heeb. 3287 Br. lime 3442

Lans. 3472 DST 3668-93 open 1 hr.

Rec. 45' wtry mud 1350# B KC 3755

Kh. 3801 Viola 3906 Simp. sh. 4013

Simp. sd. 4032 Arb. 4071 TD 4109

SCHLUMBERGER TOPS

Heeb. 3287 Br. lime 3442 Lans. 3471

Cong. 3803 Kh. 3812 Maq. 3859

Viola 3903 Simp. sh. 4014 Simp. sd. 4032

Arb. 4068

D & A

FABEN GILSTRAP