


FORM 51

Section 19 Township 24 Range 13W

Well No. #1 Toland

Company Hilton Drlg.

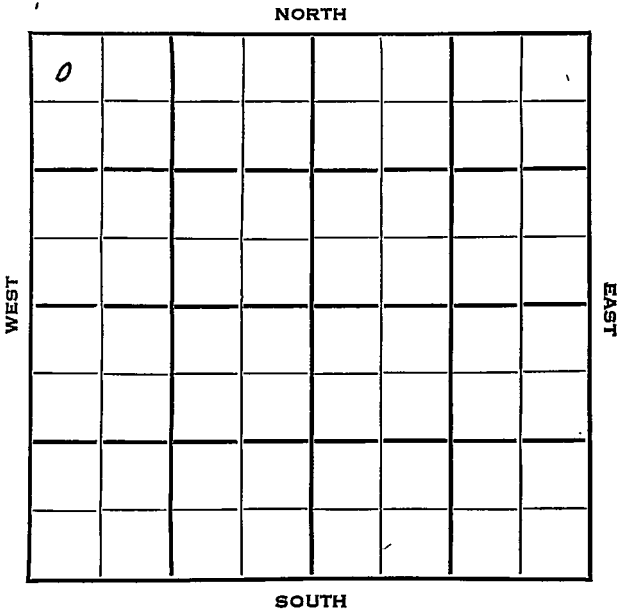

Stafford KANSAS

SEC.	TWP.	R.
19	24	13W ✓

WELL NO. 1 Toland FARM

COMPANY Hilton Drlg.


CONTRACTOR Hilton Drlg.

330 Ft. from N. Line

\_\_\_\_\_ Ft. from S. Line

\_\_\_\_\_ Ft. from E. Line

330 Ft. from W. Line

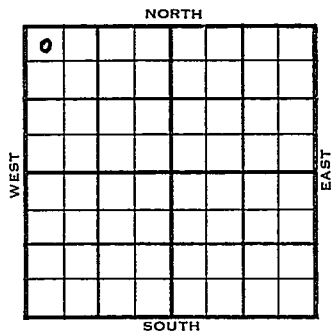

NW NW NW

	ELEVATION	REPORT
1954	1936'	

3/24 Spud 3-18-54  
8" @ 201'  
Anhy 805'  
Drlg. 2065'

3/31 Heeb 3450', Br. L. 3585', Lans 3611'  
DST 3736'-52' 1 hr, 20' socm, 90#  
Drlg 3820'

4/7 Spud 3-18-54  
D & A  
TD 3947'  
8" @ 201'  
Anhy 805', Heeb 3450', Br. Lime 3585'  
Lans 3611'  
DST 3736'-52' opn 1 hr, rec 20' socm 90#  
DST 3836'-55' opn 3/4 hr, rec 15' Mud  
O# Cong 3933'  
TD 3947'  
D & A

**ABANDONED**

County Stafford State Kansas

Sec. 19 (Blk. Twp.) 24 (Sur. Rgs.) 13W Map No.

Operator Hilton Drlg.

Well No. 1 Farm Toland

Elev. 1936 Location NW NW NW

0					

330 Ft. From N Line NW

330 Ft. From W Line Quarter

Ist. Report MAR 24 1954

Completion

Remarks

Hilton Drlg. - Contr.

Spudding Date 3-18-54

Drlg. Data Koelsch Pool

8" @ 201 Anhy 805 drlg. 2065

J. G. MCGEEHEE

County Stafford State Kansas

Sec. 19 (Blk. 24) (Sur. 13W) (Twp.) (Rge.) Map No.

Operator Hilton Drlg.

Well No. 1 Farm Toland

Elev. 1936 Location NW NW NW

0					

330 Ft. From N Line NW

330 Ft. From W Line Quarter

Ist. Report

Completion APR 7 1954

Remarks Koelsch Pool

Hilton Drlg. - Contr.

Spudding Date 3-18-54

**ABANDONED**

Drlg. Data D & A TD 3947

8" @ 201 Anhy 805 Heeb. 3450

Br. lime 3585 Lans. 3611 DST 3736-52

open 1 hr. Rec. 20' socm 90#

DST 3836-55 open 3/4 hr. Rec. 15' mud

0# Cong. 3933 TD 3947

D & A