


DX 78-1

Finney KANSAS

Section 19 Township 24 Range 32W

Well No. 1 Smith "D"

Company Stanolind

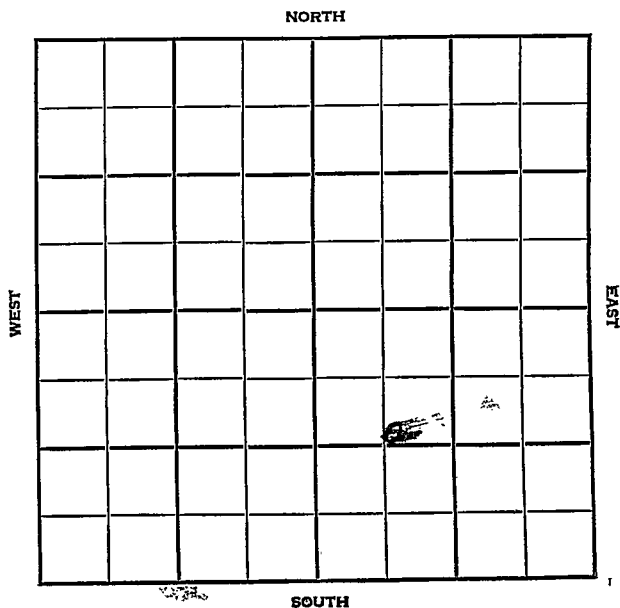

SEC. 19	TWP. 24	R. 32W
------------	------------	-----------

WELL NO. #1 Smith "D" FARM

COMPANY Stanolind

CONTRACTOR

Hugoton Pool

NORTH

1250


Ft. from N. Line

Ft. from S. Line

Ft. from E. Line

700

Ft. from W. Line

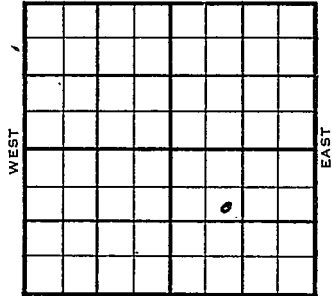

SE NW SE

1954	ELEVATION 2854'	REPORT
------	--------------------	--------

9/1

Spud 8-25-54

8" @ 905'

Her. 2500', Kri 2526' Win 2567'

TD 2631'

5" @ 2571'

WOCT.

9/15

Spud 8-25-54 - Gas Well

TD 2631'

8" @ 905'

Her. 2500', Kri 2526', Win

2567'

TD 2631'

5" @ 2571'

CO to 2631'

SP 2600' jet-frac 190,000

cfg 9 gzwph SP 2560

54/2513-22, 24/2524-28, 12/2537-

39, 72/2542-54, jet-frac

CO to 2600 315,000 cfg 30 gawph

4000A 1,337,000 cfg 3000A

1,316,000 cfg

Comp. 2,041,000 cfgrp

COMPLETED

