

KANSAS

ELECTRIC LOG

WICHITA BRANCH

CONFIDENTIAL

WELL COMPLETION REPORT AND
DRILLER'S LOGAPI No. 15 — 079 — 20,543
County Number

Operator

Anadarko Production Company

Address

P. O. Box 351, Liberal, Kansas 67901

Well No.

1

Lease Name

KRAUSS "B"

Footage Location

990 feet from NW (S) line

330 feet from (E) (W) line

Principal Contractor

Brandt Drilling Co., Inc.

Geologist

Lee Cornell

Spud Date

10/16/81

Date Completed

10/29/81

Total Depth

4110

P.B.T.D.

Directional Deviation

not applicable

Oil and/or Gas Purchaser

DRY HOLE


S. 31 T. 24S R. 2 W

Loc. C NW SW SW

County Harvey

640 Acres

N

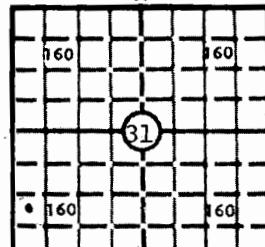

Elev.: Gr. 1410'

DF 1414' KB 1415'

CASING RECORD

Report of all strings set — surface, intermediate, production, etc.

Purpose of string	Size hole drilled	Size casing set (in O.D.)	Weight lbs/ft.	Setting depth	Type cement	Sacks	Type and percent additives
Surface	12-1/4"	8-5/8"	20#	744	Common	550	3% CaCl

LINER RECORD

PERFORATION RECORD

Top, ft.	Bottom, ft.	Sacks cement	Shots per ft.	Size & type	Depth interval

TUBING RECORD

Size	Setting depth	Packer set at

ACID, FRACTURE, SHOT, CEMENT SQUEEZE RECORD

Amount and kind of material used	Depth interval treated
	FRACTIONATED JAN 1 1984

INITIAL PRODUCTION

Date of first production	Producing method (flowing, pumping, gas lift, etc.)			
RATE OF PRODUCTION PER 24 HOURS	Oil bbis.	Gas MCF	Water bbis.	Gas-oil ratio CFPB
DRY HOLE	Producing interval(s)			
Disposition of gas (vented, used on lease or sold)				

INSTRUCTIONS: As provided in KCC Rule 82-2-125, within 90 days after completion of a well, one completed copy of this Drillers Log shall be transmitted to the State Geological Survey of Kansas, 4150 Monroe Street, Wichita, Kansas 67209. Copies of this form are available from the Conservation Division, State Corporation Commission, 245 No. Water, Wichita, Kansas 67202. Phone AC 316-522-2206. If confidential custody is desired, please note Rule 82-2-125. Drillers Logs will be on open file in the Oil and Gas Division, State Geological Survey of Kansas, Lawrence, Kansas 66044.

Operator

DESIGNATE TYPE OF COMP.: OIL, GAS,
DRY HOLE, SWDW, ETC.:

Anadarko Production Company

Well No.

Lease Name

1

KRAUSS "B"

DRY HOLE

S 31 T 24S R 2 Ex
W

WELL LOG


Show all important zones of porosity and contents thereof; cored intervals, and all drill-stem tests, including depth interval tested, cushion used, time tool open, flowing and shut-in pressures, and recoveries.

SHOW GEOLOGICAL MARKERS, LOGS RUN,
OR OTHER DESCRIPTIVE INFORMATION.

FORMATION DESCRIPTION, CONTENTS, ETC.	TOP	BOTTOM	NAME	DEPTH
Sand & Shale	0'	50'	Schlumberger	
Shale	50'	80'	Dual Induction-SFL	
Sand	80'	225'	Compensated Neutron-Forma-	
Shale	225'	375'	tion Density	
Lime w/shale stks.	375'	580'		
Shale & Lime	580'	900'		
Lime & cherty lime	900'	1040'		
Lime & Shale	1040'	1540'		
Shale & Lime	1540'	1965'		
Shale	1965'	2020'		
Lime	2020'	2075'		
Shale	2075'	2165'		
Lime, chalky	2165'	2680'		
Shale, black	2680'	2885'		
Shale & sandy shale	2885'	2895'		
Lime, brown	2895'	2900'		
Shale	2900'	2915'		
Lime, xln	2915'	3400'		
Shale & Lime	3400'	3435'		
Lime, cherty & dense	3435'	3595'		
Shales, grey & green	3595'	3778'		
Dolomite	3778'	3830'		
Lime	3830'	4110'		
RTD		4110'		

USE ADDITIONAL SHEETS, IF NECESSARY, TO COMPLETE WELL RECORD.

Date Received

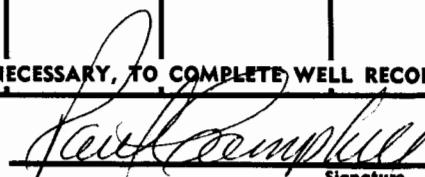

Signature

Paul Campbell, Division Operations Manager

Title

November 20, 1981

Date