



Map No. KANSAS Sec. 2 Twp. 24 R. 4<sup>w</sup>

Well No. 1-Grantz Farm  
Gled Oil - Kelly & Shell Company


NORTH

660 Ft. from N. Line

\_\_\_\_\_ Ft. from S. Line

\_\_\_\_\_ Ft. from E. Line

660 Ft. from W. Line

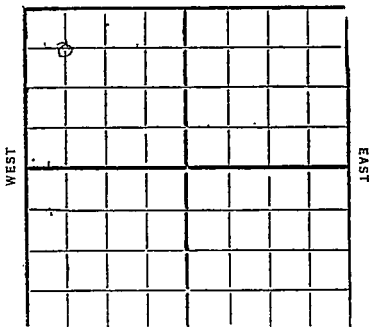

SOUTH

19.32

Date	REPORT
6/1	Loc
6/8	Rotary rig
6/15	-
6/22	Tur pipe 250'
6/29	Drelg 3330'
7/6	Top K.C. lime 2802
	Top Chat <del>3283</del> 3280
	3296 = 3293 (SLM)
	TD 3293
	Cm 8" - 3286'
7/13	Top Chat 3280.
	TD 3320 Bailing
7/20	Had. gas at 3320
	Est 7% gas & some
	water at 3370
	Est 50 bbl fluid day 3381
	drelg 3426'
7/27	TD 3495
	9,400,000 gas and
	Est 20 to 25 bbl fluid
	per hour
	60% oil

8/3 - TD 3495  
flow 115 bbl oil and  
95 bbl water 6 hr  
and 20 min

8/10 - TD 3495  
Rng tubing

8/17 - TD 3495  
flow 120 bbl 24 hr  
500 # b.p.  
25° gravity

8/24 - Cased 8" - 3286  
Chat 3280 - 3495'  
TD 3495  
flow 110 bbl oil and  
65 bbl water 24 hr  
9,400,000 cu ft gas  
34° gravity  
Comp.

*Preno*

**40 KANSAS**

W

Map No. \_\_\_\_\_ Sec. 2 Twp. 24 R. 4

Well No. 1 *Trantz*

*Gles Co. Kelly & Sheel* Company

Contractor

**FIRST REPORTS**

**SECTION PLAT**

660 Ft. from N. Line

\_\_\_\_\_ Ft. from S. Line

\_\_\_\_\_ Ft. from E. Line

660 Ft. from W. Line

0			

Location

Rig up \_\_\_\_\_

Drilling and Remarks:

**RECORD**

Cased \_\_\_\_\_ in., \_\_\_\_\_ ft.

Sand \_\_\_\_\_

Gas \_\_\_\_\_

Oil \_\_\_\_\_

Total Depth \_\_\_\_\_

**PRODUCTION**

1st 24 hrs. Nat. \_\_\_\_\_

1st 24 hrs. after shot \_\_\_\_\_

Gas \_\_\_\_\_ Cu. Ft.

Dry Hole \_\_\_\_\_

Abandoned \_\_\_\_\_

Date

JUN 1 1932 **CHAS. L. SHERWOOD**

Scout

Reno

W

40 KANSAS

Map No. \_\_\_\_\_ Sec. 7 Twp. 74 R. 4

Well No. 1 Grants

Gled. Kelly &amp; Sheel Company

\_\_\_\_\_  
Contractor

## COMPLETED

660 Ft. from N. Line

\_\_\_\_\_ Ft. from S. Line

\_\_\_\_\_ Ft. from E. Line

660 Ft. from W. Line

## SECTION PLAT

0			

Location \_\_\_\_\_

Rig up \_\_\_\_\_

Drilling and Remarks:

Ran 110 Bls Oil  
 & 65 Bls Water  
 24 Hours.  
 34 gravity.

## RECORD:

Cased 8 in., 3286 ft.  
 Sand Chat 3280-3495  
 Gas \_\_\_\_\_  
 Oil \_\_\_\_\_  
 Total Depth 3495

## PRODUCTION

1st 24 hrs. Nat. \_\_\_\_\_  
 1st 24 hrs. after shot \_\_\_\_\_  
 Gas 9,400,000 Cu. Ft.  
 Dry Hole \_\_\_\_\_  
 Abandoned \_\_\_\_\_

Date

AUG 24 1932

CHAS. L. SHERWOOD

192

Scout