

KANSAS


Stafford

Form 51-5M-7-40-Palace

Section 2 Township 24 Range 11-W

Well No. #2 Brown


Company Shell

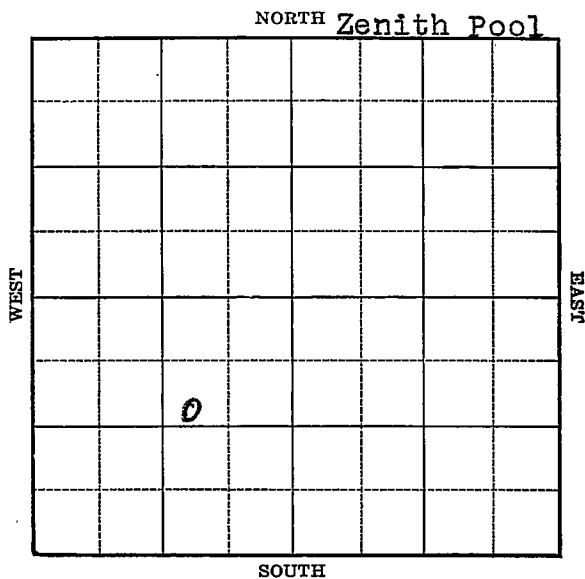

KANSAS Stafford

Sec. 2 Twp. 24 R. 11WWell No. 2 Brown FarmShell Company
(Zenith Pool)1004 Ft. from N. Line Ft. from S. Line995 Ft. from E. Line Ft. from W. Line

Elev. 1810

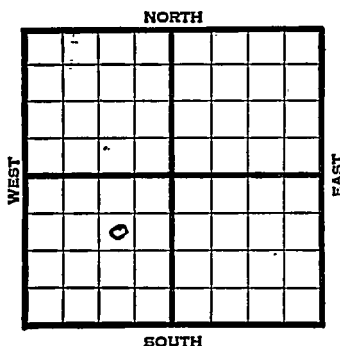

1940

REPORT

8/28 290' Run 13"

9/5 13" - 156' 8" - 284'

Drlg. 1965'

9/12 Topeka 2849'

Drlg. 3268'

9/19 Lens. 3344' Cong. 3671'

Misener 3691' Viola 3695'

Sat. 3700' T.D. 3760' R. 4".

9/26 4" - 3697' Flow 176 oil 4 hrs.

4000 acid. Flow 134 bbls. 2 hrs

10/2 Viola 3695'

4" - 3697'

T.D. 3761'

4000 acid.

Bomb potential 21,600 bbls.

Maximum 3000 bbls.

COMPLETED

Map No. 47 Sec. 2 Twp. 24 R. 11W

Well No. 2 Brown

Shell Company

Contractor

FIRST REPORT

1004 SW NE SW
Ft. from N. Line

_____ Ft. from S. Line

995 Ft. from E. Line

_____ Ft. from W. Line

ZENITH POOL

SECTION PLAT

Location _____

Rig up _____

Drilling and Remarks:

290' Run 13"

RECORD

Cased _____ in., _____ ft.

Sand _____

Gas _____

Oil _____

Total Depth _____

PRODUCTION

1st 24 hrs. Nat. _____

1st 24 hrs. after shot _____

Gas _____ Cu. Ft.

Dry Hole _____

Abandoned _____

Date

AUG 28 1940 19

S. J. LEWIS Scout

Map No. 47 Sec. 2 Twp. 24 R. 11WWell No. 2 Brown

Shell

Company

Contractor

COMPLETED

SW NE SW

1004 Ft. from N. Line Ft. from S. Line995 Ft. from E. Line Ft. from W. Line

ZENITH POOL

SECTION PLAT

Location Rig up

Drilling and Remarks:

*Vista 3695**4" C 3697**4000 acid**Born & P.D. 21600**Max 3000***RECORD**Cased in., ft.Sand Gas Oil Total Depth 3261**PRODUCTION**1st 24 hrs. Nat. 1st 24 hrs. after shot Gas Cu. Ft.Dry Hole Abandoned

Date

OCT 2 1940 19

S. J. LEWIS

Scout