

Stafford


KANSAS

Form 51—5M—11-38—Palace

Section 2 Township 24 Range 11-W


Well No. #1 McNickle

Company J. E. Crosbie et al

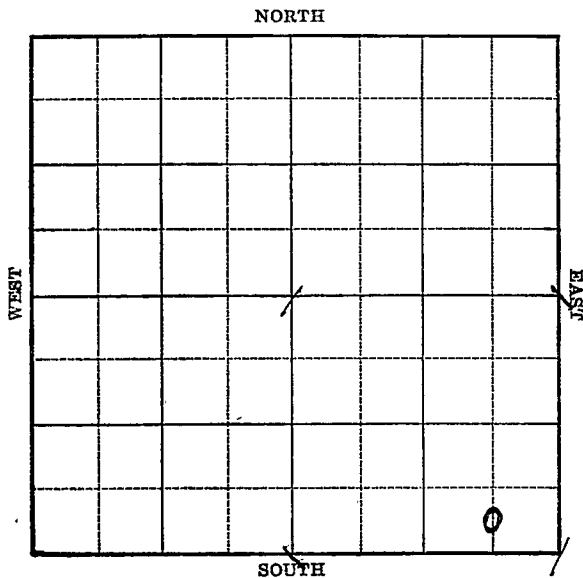

Stafford **KANSAS**Map No. 47 Sec. 2 Twp. 24 R. 11WWell No. 1 MonickleJ. E. Crosbie et al Company

Contractor

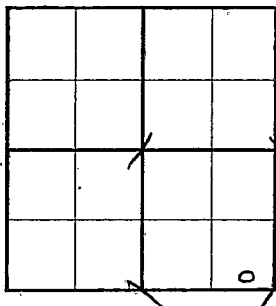FIRST REPORT*Atlantic F.O.***SECTION PLAT****C S L SE SE** Ft. from N. Line330 Ft. from S. Line660 Ft. from E. Line Ft. from W. LineLocation **X**Rig up Drilling and Remarks: **RECORD**Cased in., ft.Sand Gas Oil Total Depth **PRODUCTION**1st 24 hrs. Nat. 1st 24 hrs. after shot Gas Cu. Ft.Dry Hole Abandoned

Date

DEC 13 1938H. D. Hatfield Scout

Stafford **KANSAS**Map No. _____ Sec. 2 Twp. 24 R. 11WWell No. 1 MonickleJ. E. Crosbie etal Company

Contractor

ABANDONED

C S L SE SE

_____ Ft. from N. Line

330 Ft. from S. Line660 Ft. from E. Line

_____ Ft. from W. Line

ZENITH POOL

SECTION PLAT

			o

Location _____

Rig up _____

Drilling and Remarks:

*Last hole
skidded rig
25' west*

abd

T.D. 3466

RECORD

Cased _____ in., _____ ft.

Sand _____

Gas _____

Oil _____

Total Depth 3466

PRODUCTION

1st 24 hrs. Nat. _____

1st 24 hrs. after shot _____

Gas _____ Cu. Ft.

Dry Hole _____

Abandoned _____

Date

JAN 18 1939 19 H. D. Hatfield Scout