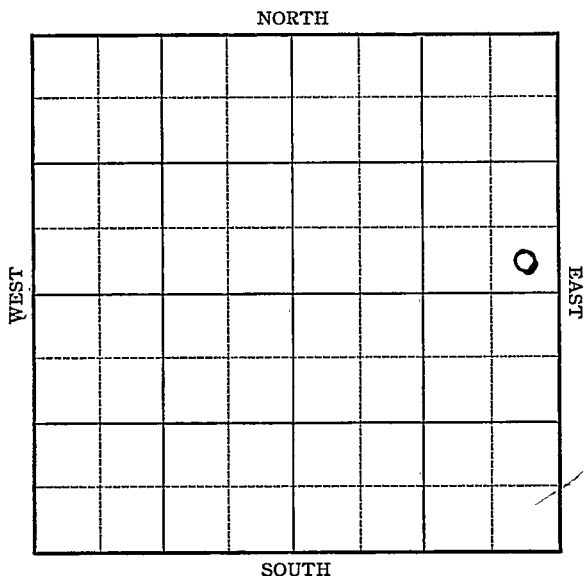
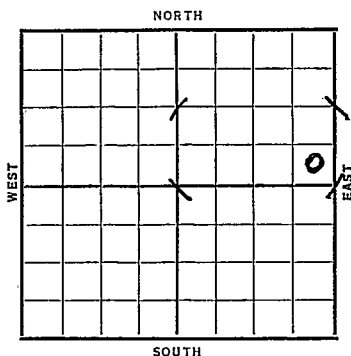


Section 2 Township 24 Range 11-WWell No. ± McNickle #2Company Republic Natural Gas.
Clyde Knight et al

Sec. 2 Twp. 24 R. 11-WWell No. #1 McNickle #2 Farm
Republic Natural Gas
Clyde Knight et al Company Ft. from N. Line330 Ft. from S. Line330 Ft. from E. Line Ft. from W. LineElev. ~~1806~~ 1805

Date

REPORT **O. W. D. D.**

1938

1/26 Cellar & Pits.

2/4 " " "

2/11 " " "

2/18 " " "

2/26 " " "

3/4 " " "

3/11 Mat'l.

3/18 R. R.

3/25 "

4/1 R U R

4/8 10" @ 225'. Anhy 510'.

Drilg. 1500'.

4/15 Drilg. 3350'.

OVER

1938

4/20 K. C. 3345-3595'.
Cherty Cong. 3668'.
Sm. S.O. 3691-96'.
Miss. 3691'.
S.O. 3696-3703'.
Cherty Viola 3713'.
Simp. sh. 3827'.
Simp. sd. 3839'.
Arb. 3897'.
T.D. 3947'.

ABANDONED

1941

O. W. D. D.

1/8 Old T.D. 3947'.
Cellar.
Old well plugged. Will drill
it again.

1/16	"	"	
1/23	"	"	
1/30	Derrick:		
2/6	"		
2/13	7" - 3705'	RUST.	
2/20	"	"	"
2/27	"	"	"
3/6	"	"	"
3/13	"	"	"
3/20	"	"	"
3/27	"	"	"

OVER

1941
4/2

Viola 3693'
7" - 3705'
T.D. 3760'
20 shots 3693-3703'
Potential 15 bbls.
42.6 Gravity


ABANDONED

Stafford **KANSAS**Map No. 47 Sec. 2 Twp. 24 R. 11WWell No. 1 McNickleClyde Knight etal Company

Contractor

FIRST REPORT

SE NE

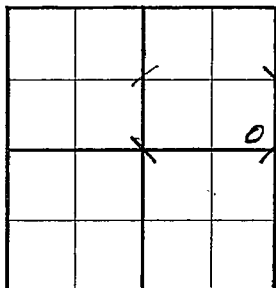 Ft. from N. Line330 Ft. from S. Line330 Ft. from E. Line Ft. from W. Line**SECTION PLAT**Location Rig up

Drilling and Remarks:

Cellar & Pits

RECORDCased in., ft.Sand Gas Oil Total Depth **PRODUCTION**1st 24 hrs. Nat. 1st 24 hrs. after shot Gas Cu. Ft.Dry Hole Abandoned

Date

JAN 26 1938₁₉H. D. Hatfield Scout

Map No. 47 Sec. 2 Twp. 24 R. 11WWell No. 1 McNickleClyde Knight etal

Company

Contractor

ABANDONED

SE NE

SECTION PLAT

			O

 Ft. from N. Line330 Ft. from S. Line330 Ft. from E. Line Ft. from W. LineLocation

RECORD

Cased in., ft.Sand Arb 3897Gas Oil Total Depth 3947

PRODUCTION

1st 24 hrs. Nat. 1st 24 hrs. after shot Gas Cu. Ft.Dry Hole Abandoned

Drilling and Remarks:

K.C 3345-3595

Cherty Cong 3668

Sm.S.O. 3691-96

MISS 3694 S.O. 3696-3703

Cherty Vio 3713

Simp sh. 3827

Simp sd. 3839

Arb 3897

Date

APR 20 1938

19

H. D. Hatfield Scout

Map No. 47 Sec. 2 Twp. 24 R. 11WWell No. 2 McNickleRepublic Natural Gas Company

Contractor

FIRST REPORT

SE NE

 Ft. from N. Line330 Ft. from S. Line330 Ft. from E. Line Ft. from W. Line

ZENITH POOL

SECTION PLAT

Location Rig up

Drilling and Remarks:

OWDD-OTD3947

Cellar

Old well plugged

Will drill it
again**RECORD**Cased in., ft.Sand Gas Oil Total Depth **PRODUCTION**1st 24 hrs. Nat. 1st 24 hrs. after shot Gas Cu. Ft.Dry Hole Abandoned

Date

JAN 8 1941

19

S. J. LEWIS Scout

Map No. 47 Sec. 2 Twp. 24 R. 11WWell No. 2 McNickleRepublic Natural Gas Company**COMPLETED**

Contractor

SE NE

SECTION PLAT

 Ft. from N. Line330 Ft. from S. Line330 Ft. from E. Line Ft. from W. Line

ZENITH POOL

Location Rig up

Drilling and Remarks:

*Vista 3693**7" C3705**20 Sh to 3693-3703**P 8 15 84 h.**42 6 9***RECORD**Cased in., ft.Sand Gas Oil Total Depth 3760**PRODUCTION**1st 24 hrs. Nat. 1st 24 hrs. after shot Gas Cu. Ft.Dry Hole Abandoned

Date

APR 2 1941 19S. J. LEWIS Scout