

KANSAS

Form 51-5M-7-40-Palace


Stafford

Section 2 Township 24 Range 11-W

Well No. #3 McNickle

Company Skelly Oil

NORTH Zenith Pool

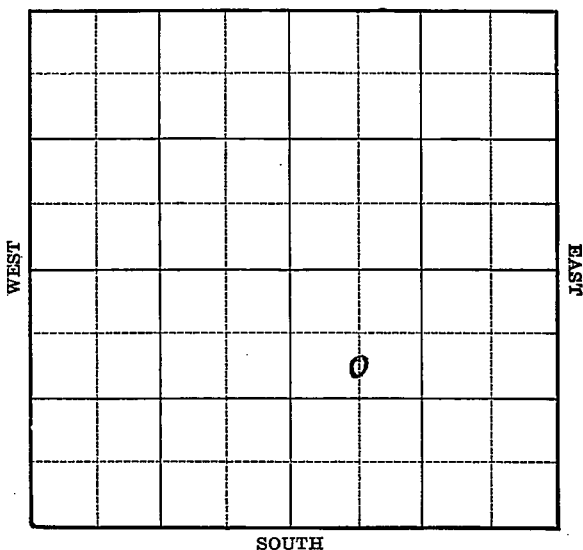

Map No. 47 Sec. 2 Twp. 24 R. 11W

Well No. 3 McNickle

Skelly Oil Company

Contractor

FIRST REPORT

C S L NW SE

990 Ft. from N. Line

 Ft. from S. Line

 Ft. from E. Line

660 Ft. from W. Line

SECTION PLAT

		X	
		O	

ZENITH POOL

Location E

Rig up

Drilling and Remarks:

RECORD

Cased in., ft.

Sand

Gas

Oil

Total Depth

PRODUCTION

1st 24 hrs. Nat.

1st 24 hrs. after shot

Gas Cu. Ft.

Dry Hole

Abandoned

Date

AUG 21 1949

S. J. LEWIS Scout

Map No. 47 Sec. 2 Twp. 24 R. 11WWell No. 3 McNickleSkelly Oil

Company

Contractor

COMPLETED

C S L NW SE

SECTION PLAT990 Ft. from N. Line Ft. from S. Line Ft. from E. Line660 Ft. from W. Line

ZENITH POOL

Location Rig up

Drilling and Remarks:

*Viola 2686**5" @ 3689**8000 accl**Bond & P. 28275**Max 3000***RECORD**Cased in., ft.Sand Gas Oil Total Depth 3750**PRODUCTION**1st 24 hrs. Nat. 1st 24 hrs. after shot Gas Cu. Ft.Dry Hole Abandoned

Date

OCT 9 1940S. J. LEWIS

Scout