


Section 2 Township 24 Range 11-WWell No. #1-A McNickleCompany J. E. Crosbie et al

Zenith Pool

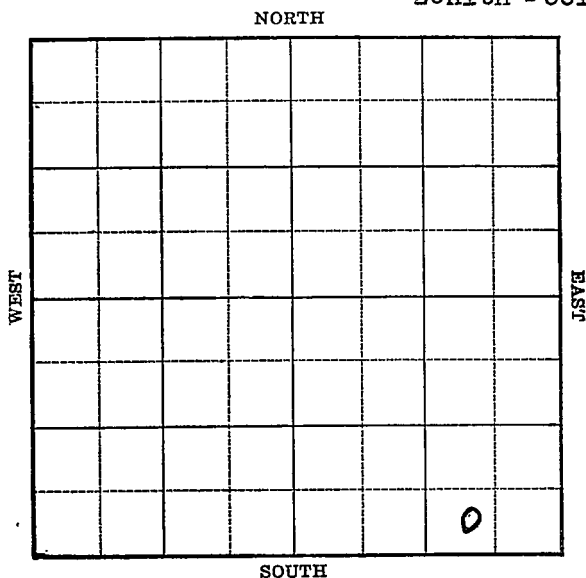

Stafford KANSAS

Map No. _____ Sec. 2 Twp. 24 R. 11WWell No. 1A-McNickle *Twin To
Lost hole*J. E. Crosbie etal Company

Contractor

~~FIRST~~ REPORT

Approx.

C S L SE SE

_____ Ft. from N. Line

330 Ft. from S. Line685 Ft. from E. Line

_____ Ft. from W. Line

SECTION PLAT

			0

ZENITH POOL

Location _____

Rig up _____

Drilling and Remarks:

10"-248WOC

RECORD

Cased _____ in., _____ ft.

Sand _____

Gas _____

Oil _____

Total Depth _____

PRODUCTION

1st 24 hrs. Nat. _____

1st 24 hrs. after shot _____

Gas _____ Cu. Ft.

Dry Hole _____

Abandoned _____

Date

JAN 18 1939

19

H. D. Hatfield

Scout

Stafford

KANSAS

Map No. _____ Sec. 2 Twp. 24 R. 11WWell No. 1-A McNickle (Twin to lost hold)
J. E. Crosbie et al Company

Contractor _____

ABANDONED

C S L SE SE

_____ Ft. from N. Line

330 Ft. from S. Line685 Ft. from E. Line

_____ Ft. from W. Line

SECTION PLAT

ZENITH POOL

Location _____

Rig up _____

Drilling and Remarks:

Misener 3685
 Viola 3698
 STain oil 3696-3708
 T.D. 3718
 D & A

RECORD

Cased _____ in., _____ ft.

Sand _____

Gas _____

Oil _____

Total Depth _____

PRODUCTION

1st 24 hrs. Nat. _____

1st 24 hrs. after shot _____

Gas _____ Cu. Ft.

Dry Hole _____

Abandoned _____

Date

Feb. 1, 1939 H. D. Hatfield. Scout