

KANSAS


Form 51-5M-7-39-Palace

Stafford

Section 2 Township 24 Range 11-W

Well No. #1 McKickle

Company Republic Natural Gas

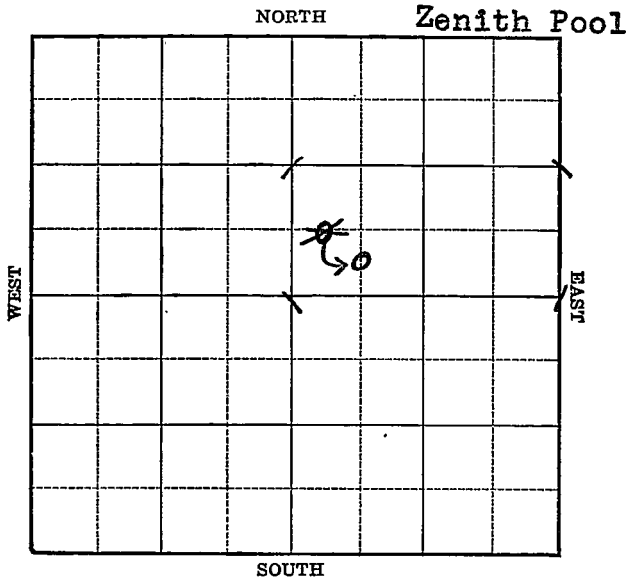

KANSAS

Stafford

Sec. 2 Twp. 24 R. 11-WWell No. #1 McKickle Farm

Republic Natural Gas

Company

(Zenith)


Ft. from N. Line

330
~~660~~ Ft. from S. Line

Ft. from E. Line

660
~~330~~ Ft. from W. Line

Elev. 1806

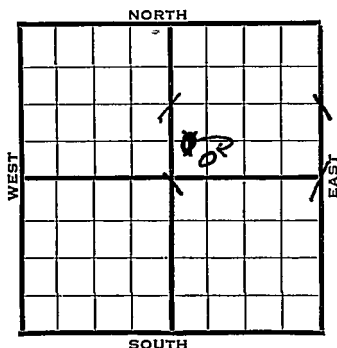

1940	REPORT				
6/19	Location				
6/27	Derrick.				
7/3	Tools.				
7/11	8" - 309' Drlg. 2610'				
7/18	Drlg. 3455'				
7/25	Viola 3677' T.D. 3386'				
	5" - 3677' RUST.				
8/2	T.D. 3772' Flow 10 bbls. oil				
	per hour.				
8/8	"	"			
8/14	"	"			
8/22	T.D. 3725' Flow 6 bbls. per hr.				
8/29	"	"	"	"	"
9/5	"	"	"	"	"
9/12	"	"	"	"	"
9/19	"	"	"	"	"
9/26	"	"	"	"	"
10/3	"	"	"	"	"
10/10	"	"	"	"	"
10/17	"	"	"	"	"
	OVER				

1940

10/23 Viola 3677'

5" - 3677'

T.D. 3725'

Potential 15 bbls ., pump.

COMPLETED

Map No. 47 Sec. 2 Twp. 24 R. 11WWell No. 1 McKickleRepublic Natural Gas Company


Contractor

FIRST REPORT

C W L SW NE

 Ft. from N. Line660 Ft. from S. Line Ft. from E. Line330 Ft. from W. Line

ZENITH POOL

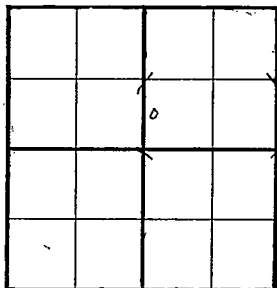SECTION PLATLocation XRig up

Drilling and Remarks:


RECORDCased in., ft.Sand Gas Oil Total Depth **PRODUCTION**1st 24 hrs. Nat. 1st 24 hrs. after shot Gas Cu. Ft.Dry Hole Abandoned

Date

JUN 19 1940 19S. J. LEWIS Scout

Map No. 47 Sec. 2 Twp. 24 R. 11WWell No. 1 McKickleRepublic Natural Gas CompanyCORRECTION

Contractor

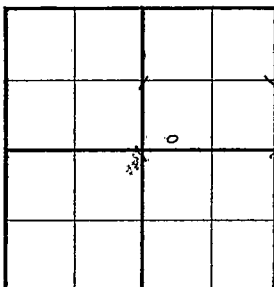SECTION PLAT**C S L SW NE** Ft. from N. Line330 Ft. from S. Line Ft. from E. Line660 Ft. from W. Line**ZENITH POOL**Location Rig up

Drilling and Remarks:

Reported**C W L SW NE****RECORD**Cased in., ft.Sand Gas Oil Total Depth **PRODUCTION**1st 24 hrs. Nat. 1st 24 hrs. after shot Gas Cu. Ft.Dry Hole Abandoned

Date

JUL 6 1940 19S. J. LEWIS Scout

Map No. 47 Sec. 2 Twp. 24 R. 11WWell No. 1 McKickle

Republic Natural Gas Company

Contractor

COMPLETED

C S L SW NE

SECTION PLAT

_____ Ft. from N. Line

330 Ft. from S. Line

_____ Ft. from E. Line

660 Ft. from W. Line

ZENITH POOL

Location _____

Rig up _____

Drilling and Remarks:

*Vista 8677**5" C 3077**Pump 15 Bx.*

RECORD

Cased _____ in., _____ ft.

Sand _____

Gas _____

Oil _____

Total Depth 2725

PRODUCTION

1st 24 hrs. Nat. _____

1st 24 hrs. after shot _____

Gas _____ Cu. Ft.

Dry Hole _____

Abandoned _____

Date

OCT 23 1940 19

S. J. LEWIS Scout