

KANSAS


Stafford County

FORM 51 5M BR1X

Section 2 Township 24S Range 11W

Well No. #1, M. Volker

Company Hershfield et al

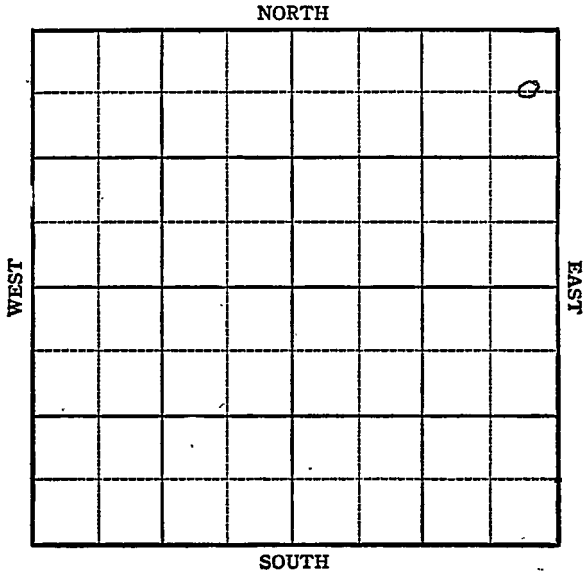

Sec. 2 Twp. 24 R. 11W

Well No. #1 M. Volker Farm

Hershfield et al Company


Zenith

660 Ft. from N. Line

_____ Ft. from S. Line

330 Ft. from E. Line

_____ Ft. from W. Line

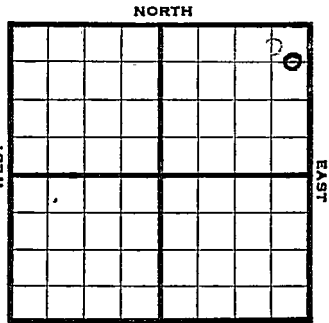

C E L NE NE *Elev. 1810*

R E P O R T

1944

12/27 Location

1945

1/3

"

1/10 10 @ 268 Drlg 340

1/17, Drlg 2630

1/26 Drlg. 3420'
Lans 3358

1/31 Viola 3726-3730
TD 3730
5" @ 3727' RUST

2/7 " " " "

2/14 " " " "

2/21 " " " "

2/28 TD 3751
2400' oil in 20 hrs SW

3/7 TD 3751

3/14 500 acid Swb 30 oil PH

3/23 " " " " " "

3/29 " " " " " "

4/5 " " " " " "

4/12 " " " " " "

4/20 " " " " " "

4/27 " " " " " "

OVER

1945

5/3	Pump 129	oil	plus	111	wtr.	24	hrs.
5/10	"	"	"	"	"	"	"
5/17	"	"	"	"	"	"	"
5/24	"	"	"	"	"	"	"
5/31	"	"	"	"	"	"	"
6/8	"	"	"	"	"	"	"
6/14	"	"	"	"	"	"	"
6/21	"	"	"	"	"	"	"
6/28	"	"	"	"	"	"	"
7/11	Viola 3726						
	5" @ 3727						
	500 acid.						
	TD 3751						
	Pump 15 oil plus 40 W Pot.						
	Grav. 42.0						

COMPLETED

Pool Name Z enith

Map No. 47 Sec. 2 Twp. 24 R. 11W

Well No. 1 M. Volker

Hershfield etal. Company

FIRST REPORT

Contractor

C E L N E N E

SECTION PLAT

660 Ft. from N. Line

_____ Ft. from S. Line

330 Ft. from E. Line

_____ Ft. from W. Line

Stafford County

Location X

Rig up _____

Drilling and Remarks:

RECORD

Cased _____ in., _____ ft.

Sand _____

Gas _____

Oil _____

Total Depth _____

PRODUCTION

1st 24 hrs. Nat. _____

1st 24 hrs. after shot _____

Gas _____ Cu. Ft.

Dry Hole _____

Abandoned _____

Date

DEC 27 1944 19

S. J. LEWIS Scout

KANSAS Kansas Pool Name Zenith

Map No. 47 Sec. 2 Twp. 24 R. 11W

Well No. 1 M. Volker

Hershfield etal Company

COMPLETED

Contractor

C E L N E N E

E 11870
SECTION PLAT

660 Ft. from N. Line

 Ft. from S. Line

330 Ft. from E. Line

 Ft. from W. Line

Stafford County

Location _____

Rig up _____

Drilling and Remarks:

Vista 3726
5" Co 3727
500 acid
Prng soil +
40 W Pt
42° G

RECORD

Cased _____ in., _____ ft.

Sand _____

Gas _____

Oil _____

Total Depth 3257

PRODUCTION

1st 24 hrs. Nat. _____

1st 24 hrs. after shot _____

Gas _____ Cu. Ft.

Dry Hole _____

Abandoned _____

Date

JUL 11 1945

19

S. J. LEWIS

Scout