

KANSAS


Form 51-5M-7-39-Palace

Stafford

Section 2 Township 24 Range 11-W

Well No. #4 Turner

Company Deep Rock

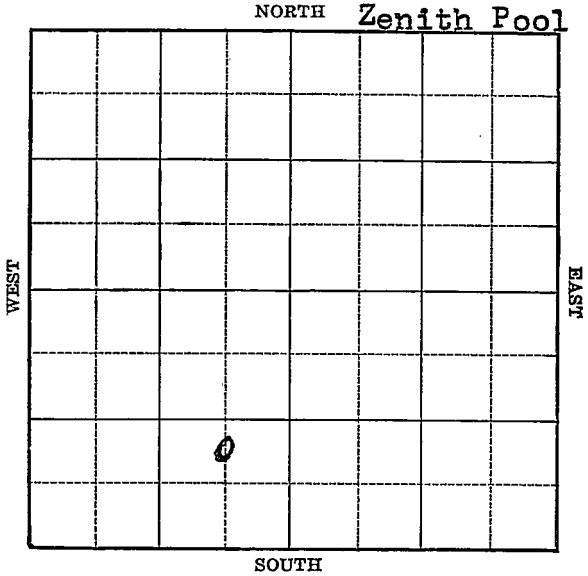

Sec. 2 Twp. 24 R. 11-W

Well No. #4 Turner Farm

Deep Rock Company

(Zenith)


_____ Ft. from N. Line

990 Ft. from S. Line

660 Ft. from E. Line

_____ Ft. from W. Line

Elev 1808 Est DF
1805 GR

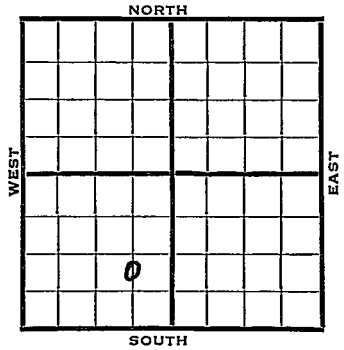

1940	REPORT
4/10	Location
4/18	Rotary.
4/25	10" - 250' Drlg. 821'
5/2	Drlg. 2387'
5/9	Viola 3683'? Coring 3685'
5/16	Viola 3700' S.O. 3702½' T.D. 3765' 7" - 3703' RUST.
5/22	Viola 3700'
	7" - 3703'
	T.D. 3765'
	8000 acid.
	Bomb potential 5686 bbls.
	Maximum 3000 bbls.
	COMPLETED

Map No. 47 Sec. 2 Twp. 24 R. 11W

Well No. 4 Turner

Deep Rock Company

Contractor

FIRST REPORT

C $N\frac{1}{2}$ SE SW

 Ft. from N. Line

990 Ft. from S. Line

660 Ft. from E. Line

 Ft. from W. Line

SECTION PLAT

	●		

ZENITH POOL

Location X

Rig up

Drilling and Remarks:

RECORD

Cased in., ft.

Sand

Gas

Oil

Total Depth

PRODUCTION

1st 24 hrs. Nat.

1st 24 hrs. after shot

Gas Cu. Ft.

Dry Hole

Abandoned

Date

APR 10 1940₁₉

S. J. LEWIS Scout

Map No. 47 Sec. 2 Twp. 24 R. 11W

Well No. 4 Turner

Deep Rock Company

COMPLETED Contractor

C N L SE SW

 Ft. from N. Line

990 Ft. from S. Line

660 Ft. from E. Line

 Ft. from W. Line

SECTION PLAT

	•		

ZENITH POOL

Location

Rig up

Drilling and Remarks:

Verla 3700

7" @ 3703

500 acid

Bom + PT 5286

Maximum 3000

RECORD

Cased in., ft.

Sand

Gas

Oil

Total Depth 3265

PRODUCTION

1st 24 hrs. Nat.

1st 24 hrs. after shot

Gas Cu. Ft.

Dry Hole

Abandoned

Date

MAY 22 1940

S. J. LEWIS Scout