


Section 2 Township 24 Range 12W

Well No. #2 Porter "B"

Company Cities Service

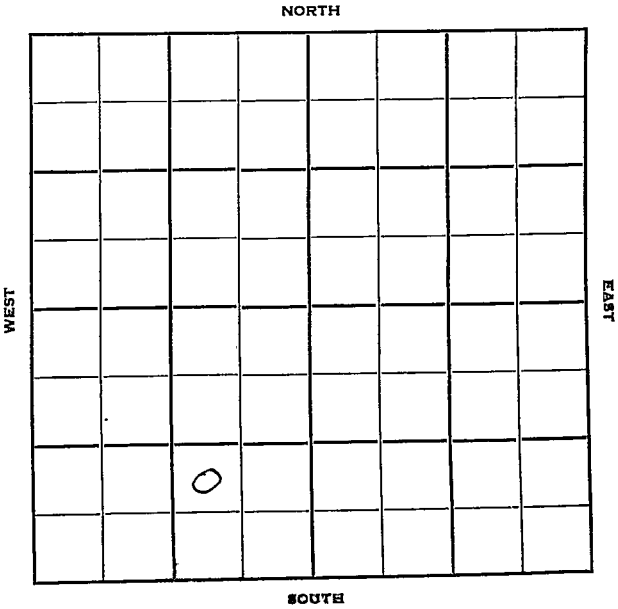

Stafford

KANSAS

Sec. 2 Twp. 24 R. 12W

Well No. #2 Porter "B" Farm

Cities Service Company

Holme Drlg. Contractor

Hildebrand Pool


NORTH

 Ft. from N. Line

990' Ft. from S. Line

990' Ft. from E. Line

 Ft. from W. Line

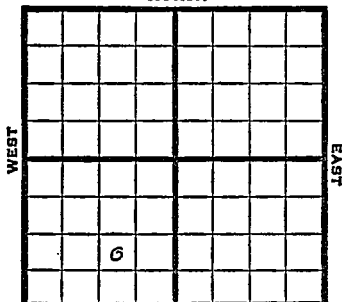

NW SE SW

SOUTH

1950

Elev 1861

REPORT

8/30

Location

11/1

Spud 9-5-50

8" @ 318

Lans 3436

Ch cong 3739

Kinderhook 3745 Viola 3808-11

5" @ 3810

TD 3824

1000 A 1 boph 7 hr

3000 A

3 boph for 7 hr DD 3829

B/50 go 50 BW 12 hr

Comp 9 bopd 1% wtr

TD 3829

Completed

COMPLETED



Well No. 2 Farm Porter "B"

Elev.	Location	NW	SE	SW
-------	----------	----	----	----

FIRST REPORT

990 Ft. From' S Line SW

990 Ft. From E Line Quarter

1st. Report **AUG 30 1950**

Completion


Remarks

Spudding Date:

Drlg. Data	Hildebrand Pool
------------	-----------------

Location

County Stafford State Kansas
 Sec. 2 (Blk. 24 (Sur. 12W Map No.
 Operator Cities Service
 Well No. 2 Farm Porter "B"
 Elev. 1861 Location NW SE SW

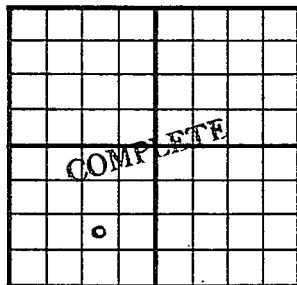

990 Ft. From S Line SW
990 Ft. From E Line Quarter
 1st. Report
 Completion NOV 1 1950
 Remarks Hildebrand Pool
Holme Drlg. - Contr.
 Spudding Date 9-5-50

Drlg. Data Oil well TD 3829
8" @ 318 Lans. 3436 Ch. Cong. 3739
Kinderhook 3745 Viola 3808-11
5" @ 3810 TD 3824 1000 A 1 boph 7 hr.
3000 A 3 boph for 7 hr. DD 3829
R/ 50 go 50 gw 12 hr.
Comp. 9 bopd 1% water

J. E. TYRA